
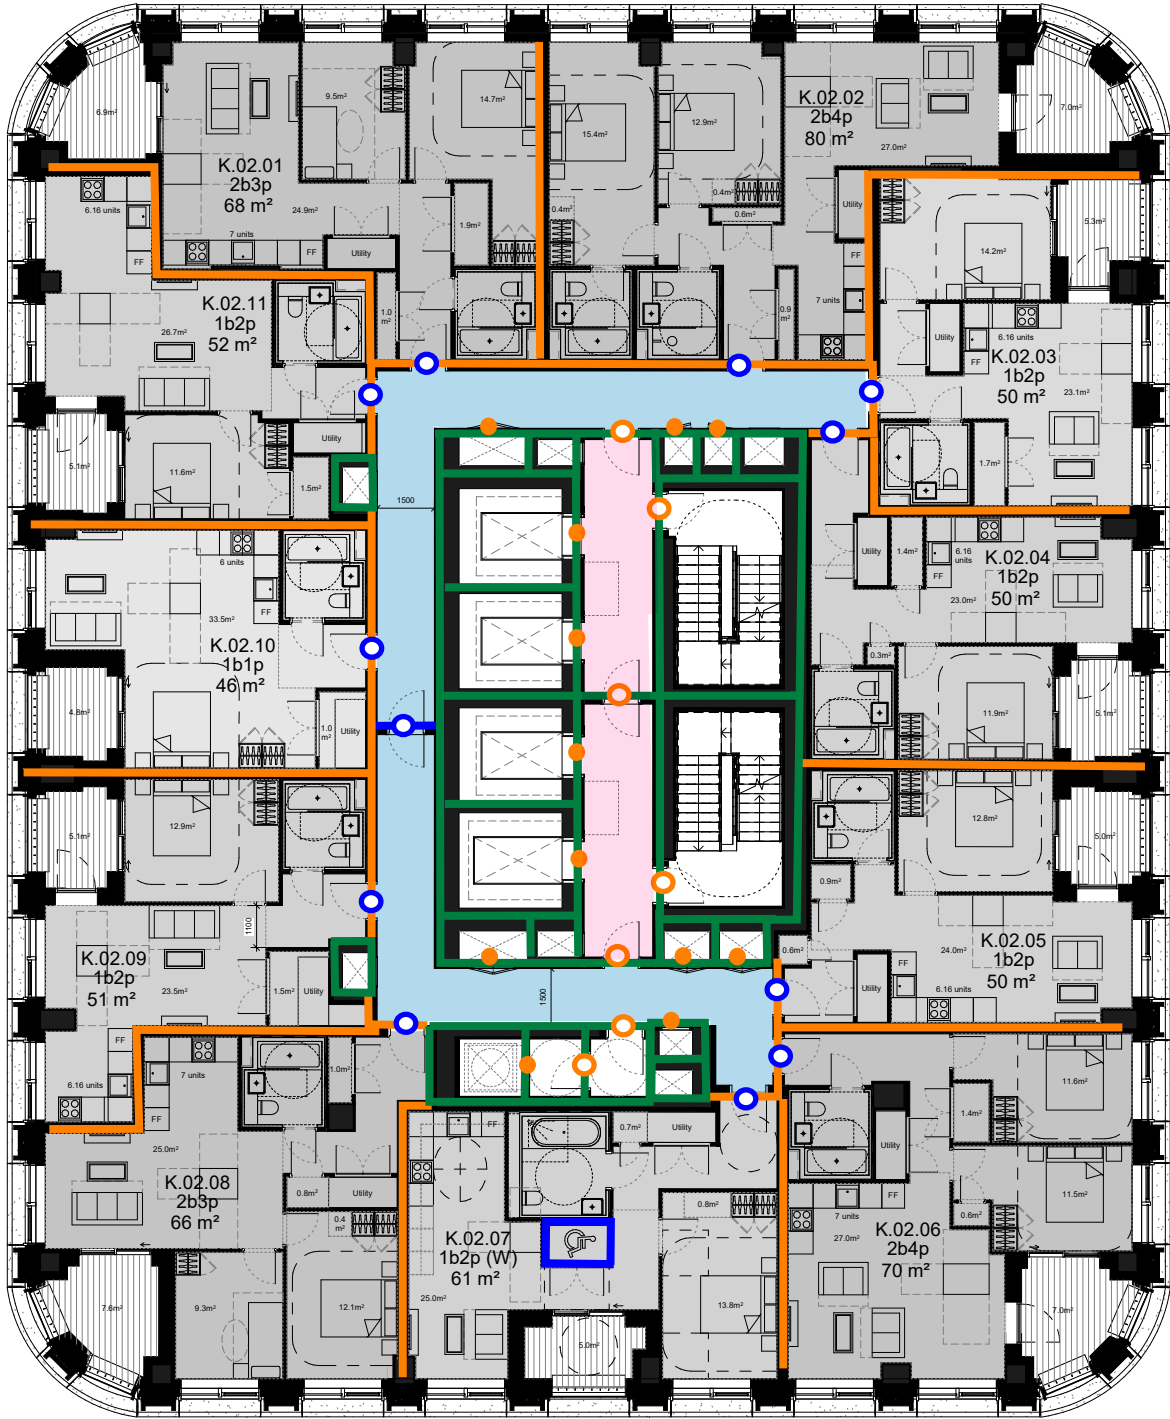


Annotation	Description
	30 Minutes FR
	60 Minutes FR
	120 Minutes FR
	240 Minutes FR
	FD 30 S Fire Door
	FD 30 Fire Door
	FD 60 S Fire Door
	FD 60 Fire Door
	FD 120 S Fire Door
	FD 120 Fire Door

Issued to Fire Consultant	18/11/22	EJ	P7
Minor updates to areas	18/11/22	EJ	P6
Layouts Changes due to Structural Coordination	14/11/22	EJ	P5
Layouts Changes due to Structural Coordination	13/11/22	EJ	P4
For Information	10/10/22	EJ	P3
Issued to GLA	16/09/22	EJ	P2
Issued as Draft	13/09/22	EJ	P1
Description	Date	CHK	Rev

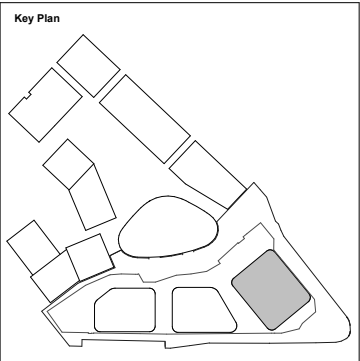

All fire safety mark ups are consistent throughout Block K levels.

Annotation	Description
	30 Minutes FR
	60 Minutes FR
	120 Minutes FR
	240 Minutes FR
	FD 30 S Fire Door
	FD 30 Fire Door
	FD 60 S Fire Door
	FD 60 Fire Door
	FD 120 S Fire Door
	FD 120 Fire Door

Issued to Fire Consultant	18/11/22	EJ	P6
Minor updates to areas	18/11/22	EJ	P5
Layouts Changes due to Structural Coordination	14/11/22	EJ	P4
Layouts Changes due to Structural Coordination	13/11/22	EJ	P3
Columns omitted until further coordination	11/10/22	EJ	P2
For Information	10/10/22	EJ	P1
Description	Date	CHK	Rev

SQUIRE & PARTNERS

Squire and Partners LLP
The Department Store
248 Ferndale Road, London SW9 8FR
T: 020 7278 5555

info@squireandpartners.com
www.squireandpartners.com



Project
Paddington Green Police Station
London, W2

Title
Block K
Typical 1A - Level 2
Tenure Plan

Suitability Status
S2 For Information

Date Scale @ ISO A1 Job Number
22/08/22 1:100 15044

Drawing Number Revision
15044-SQP-03-02-DR-A-20901 P6

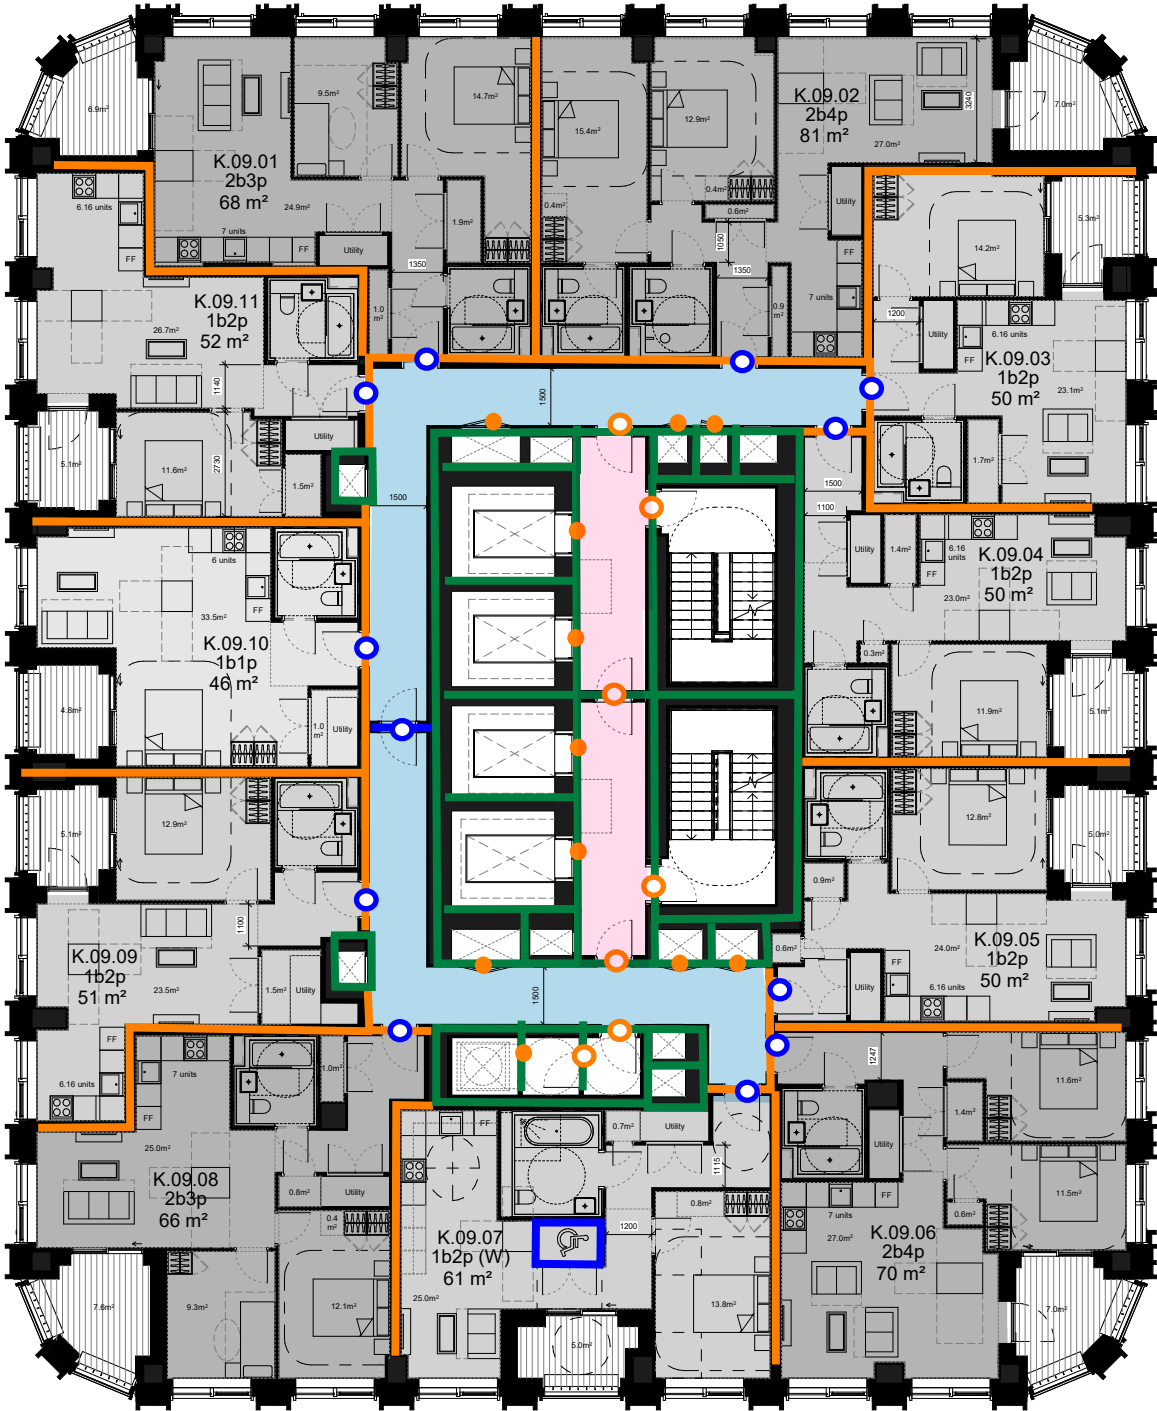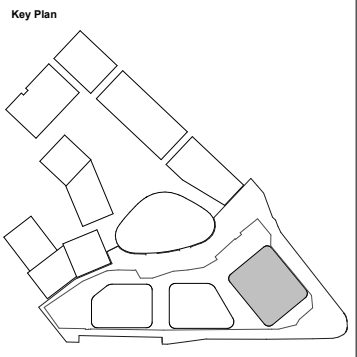










 
All fire safety mark ups are consistent throughout Block K levels.



Issued to Fire Consultant	18/11/22	EJ	P10
Minor updates to areas	18/11/22	EJ	P9
Layouts Changes due to Structural Coordination	14/11/22	EJ	P8
Layouts Changes due to Structural Coordination	13/11/22	EJ	P7
Columns omitted until further coordination	11/10/22	EJ	P6
For information	10/10/22	EJ	P5
Levels 2-10 in Title Amended to Levels 2-11 (Drawing Ending 20902 - Typical 1A Omitted)	21/09/22	EJ	P4
Issued to GLA	16/09/22	EJ	P3
Issued to GLA	06/09/22	EJ	P2
Issued to GLA	05/09/22	EJ	P1
Description	Date	Chk	Rev

SQUIRE & PARTNERS

Squire and Partners LLP
The Department Store
248 Ferndale Road, London SW9 8FR
T: 020 7278 5555
info@squireandpartners.com
www.squireandpartners.com

Project		
Paddington Green Police Station London, W2		
Title		
Block K Typical 1 - Levels 3-11 Tenure Plan		
Suitability	Status	
S2	For Information	
Date	Scale @ ISO A1	Job Number
22/08/22	1:100	15044
Drawing Number	Revision	
15044-SQP-03-09-DR-A-20902	P10	

Annotation	Description
	30 Minutes FR
	60 Minutes FR
	120 Minutes FR
	240 Minutes FR
	FD 30 S Fire Door
	FD 30 Fire Door
	FD 60 S Fire Door
	FD 60 Fire Door
	FD 120 S Fire Door
	FD 120 Fire Door

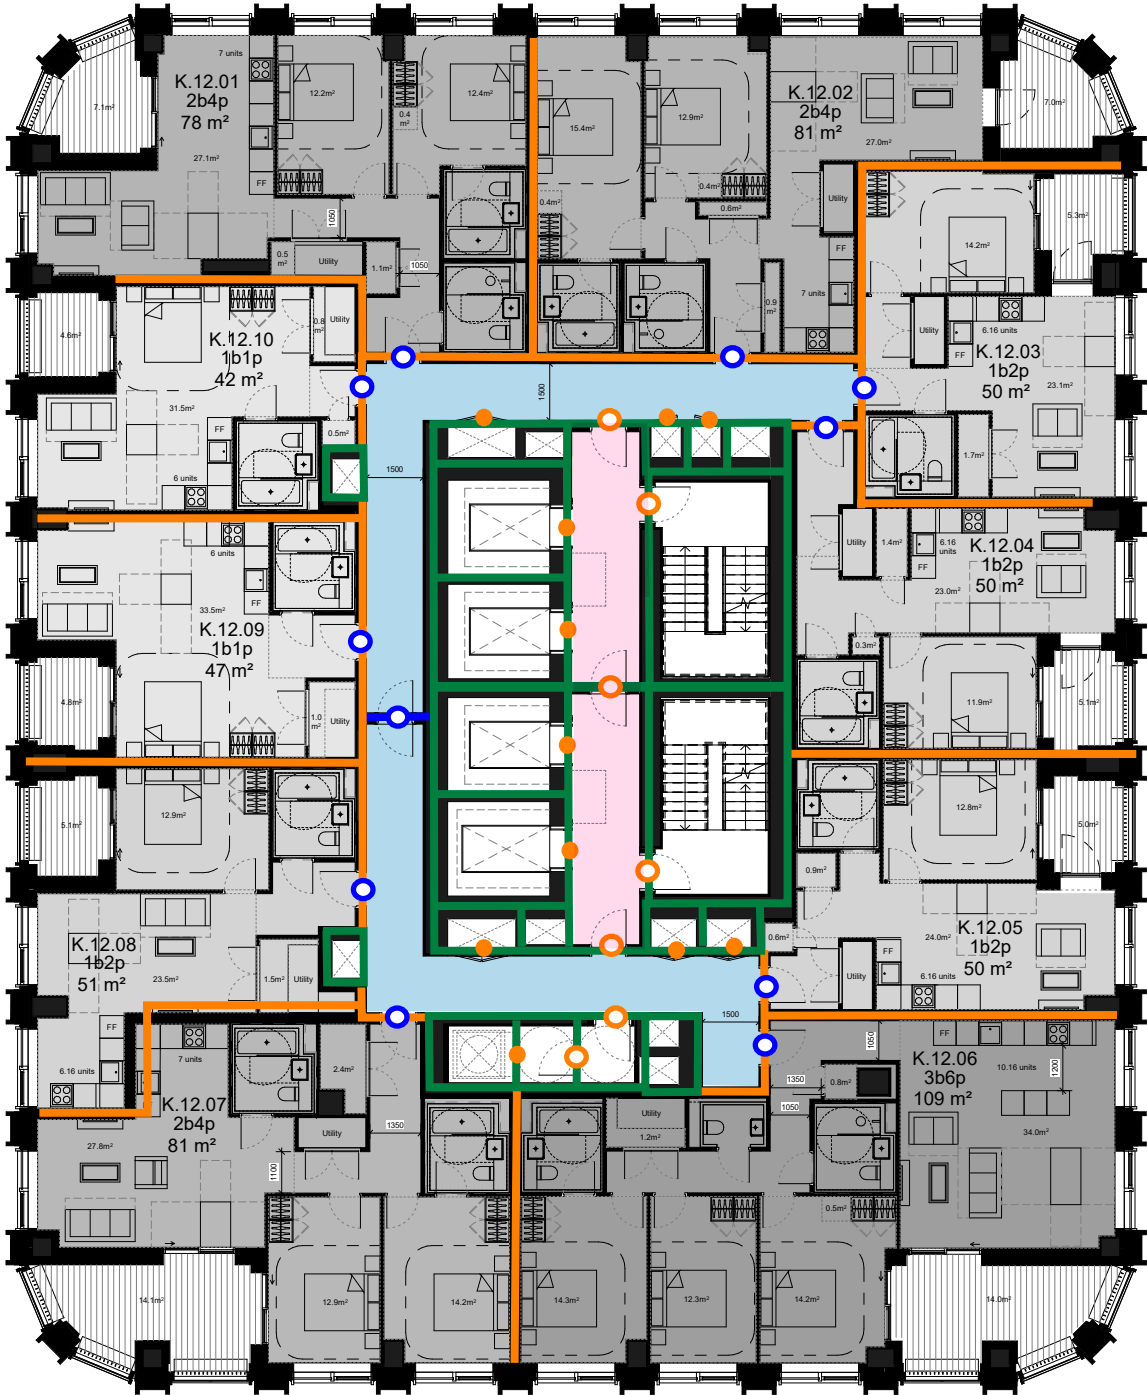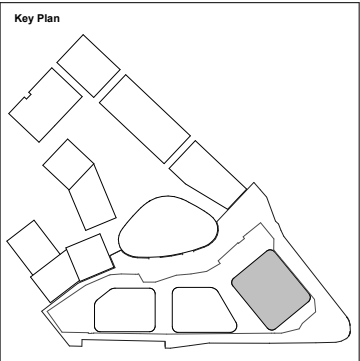

All fire safety mark ups are consistent throughout Block K levels.

Annotation	Description
	30 Minutes FR
	60 Minutes FR
	120 Minutes FR
	240 Minutes FR
	FD 30 S Fire Door
	FD 30 Fire Door
	FD 60 S Fire Door
	FD 60 Fire Door
	FD 120 S Fire Door
	FD 120 Fire Door

Layouts Changes due to Structural Coordination	14/11/22	EJ	P4
Layouts Changes due to Structural Coordination	13/11/22	EJ	P3
Columns omitted until further coordination	11/10/22	EJ	P2
For Information	10/10/22	EJ	P1
Description	Date	Chk	Rev

SQUIRE & PARTNERS

Squire and Partners LLP
The Department Store
248 Ferndale Road, London SW9 8FR
T: 020 7278 5555
info@squireandpartners.com
www.squireandpartners.com



Project
Paddington Green Police Station
London, W2

Title
Block K
Typical 2A - Level 12
Tenure Plan

Suitability Status
S2 For Information

Date Scale @ ISO A1 Job Number
07/10/22 1:100 15044

Drawing Number Revision
15044-SQP-03-12-DR-A-20903 P4

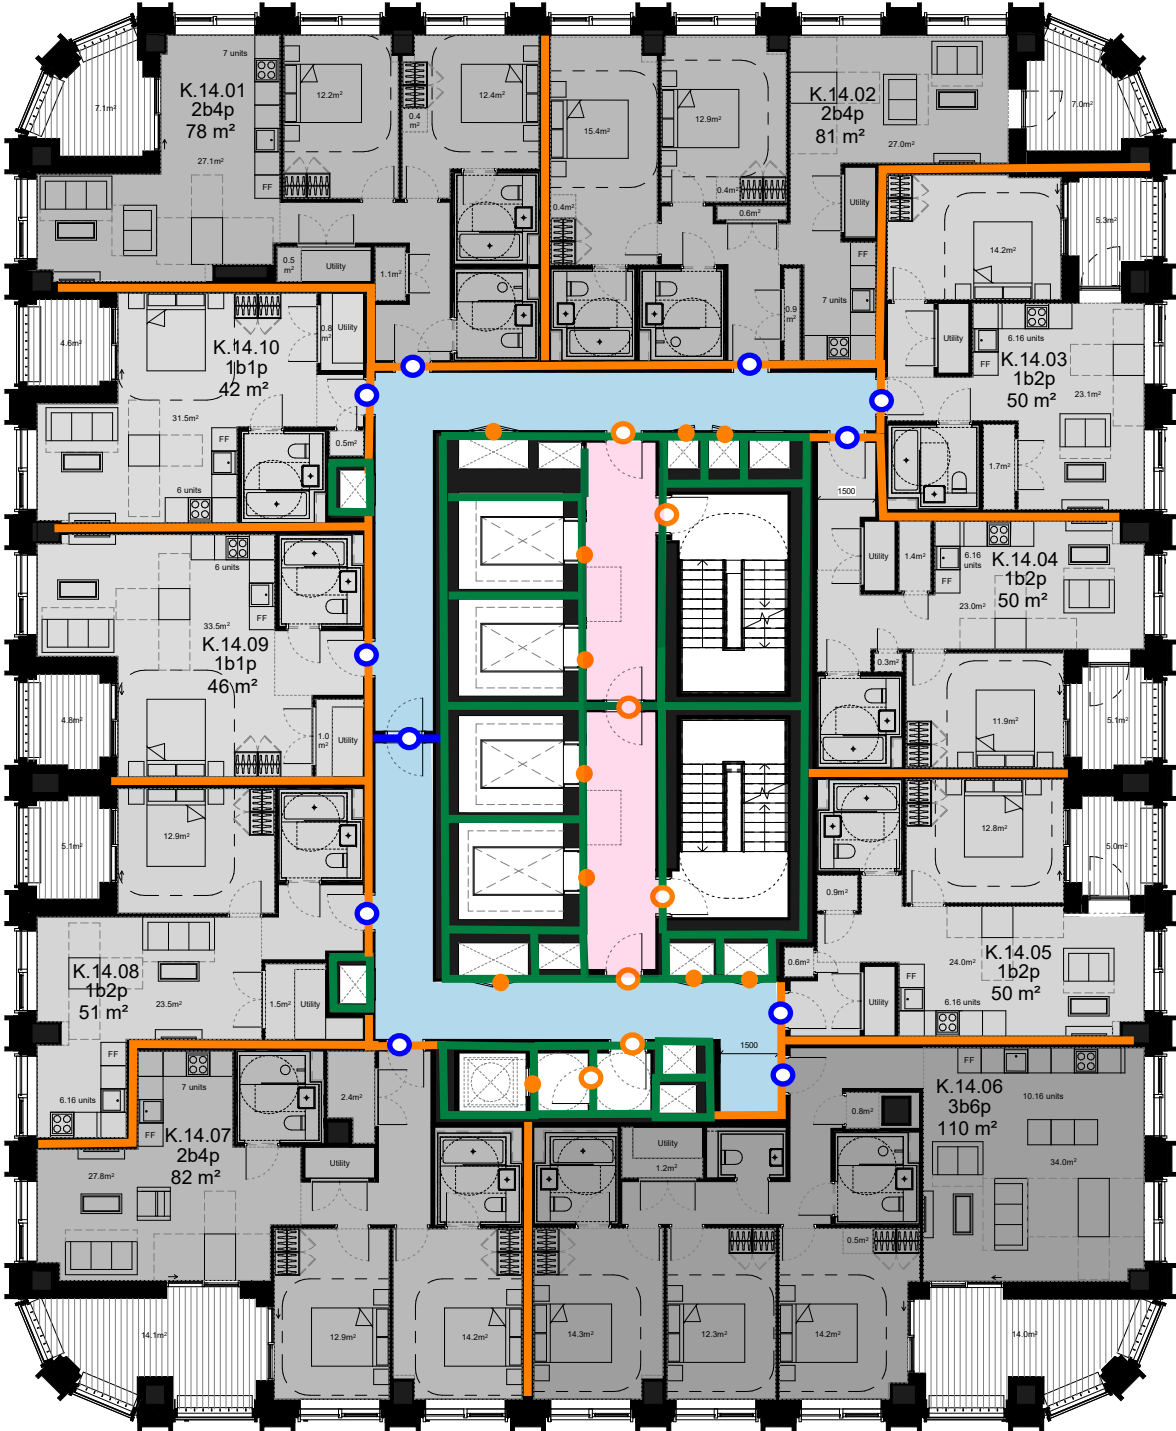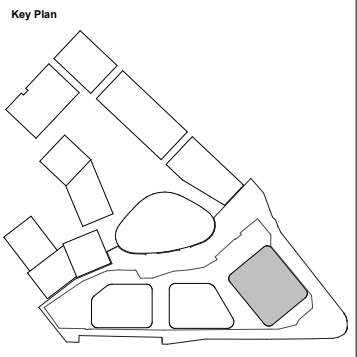

All fire safety mark ups are consistent throughout Block K levels.

Issued to Fire Consultant	18/11/22	EJ	P8
Minor updates to areas	18/11/22	EJ	P7
Layouts Changes due to Structural Coordination	14/11/22	EJ	P6
Layouts Changes due to Structural Coordination	13/11/22	EJ	P5
For Information	10/10/22	EJ	P4
Drawing Ending 20902 Changed from Typical 1A to Typical 2 (Previously 20903)	21/09/22	EJ	P3
Issued to GLA	16/09/22	EJ	P2
Issued to GLA	06/09/22	EJ	P1
Description	Date	Chk	Rev



SQUIRE & PARTNERS

Squire and Partners LLP
The Department Store
248 Ferndale Road, London SW9 8FR
T: 020 7278 5555
info@squireandpartners.com
www.squireandpartners.com







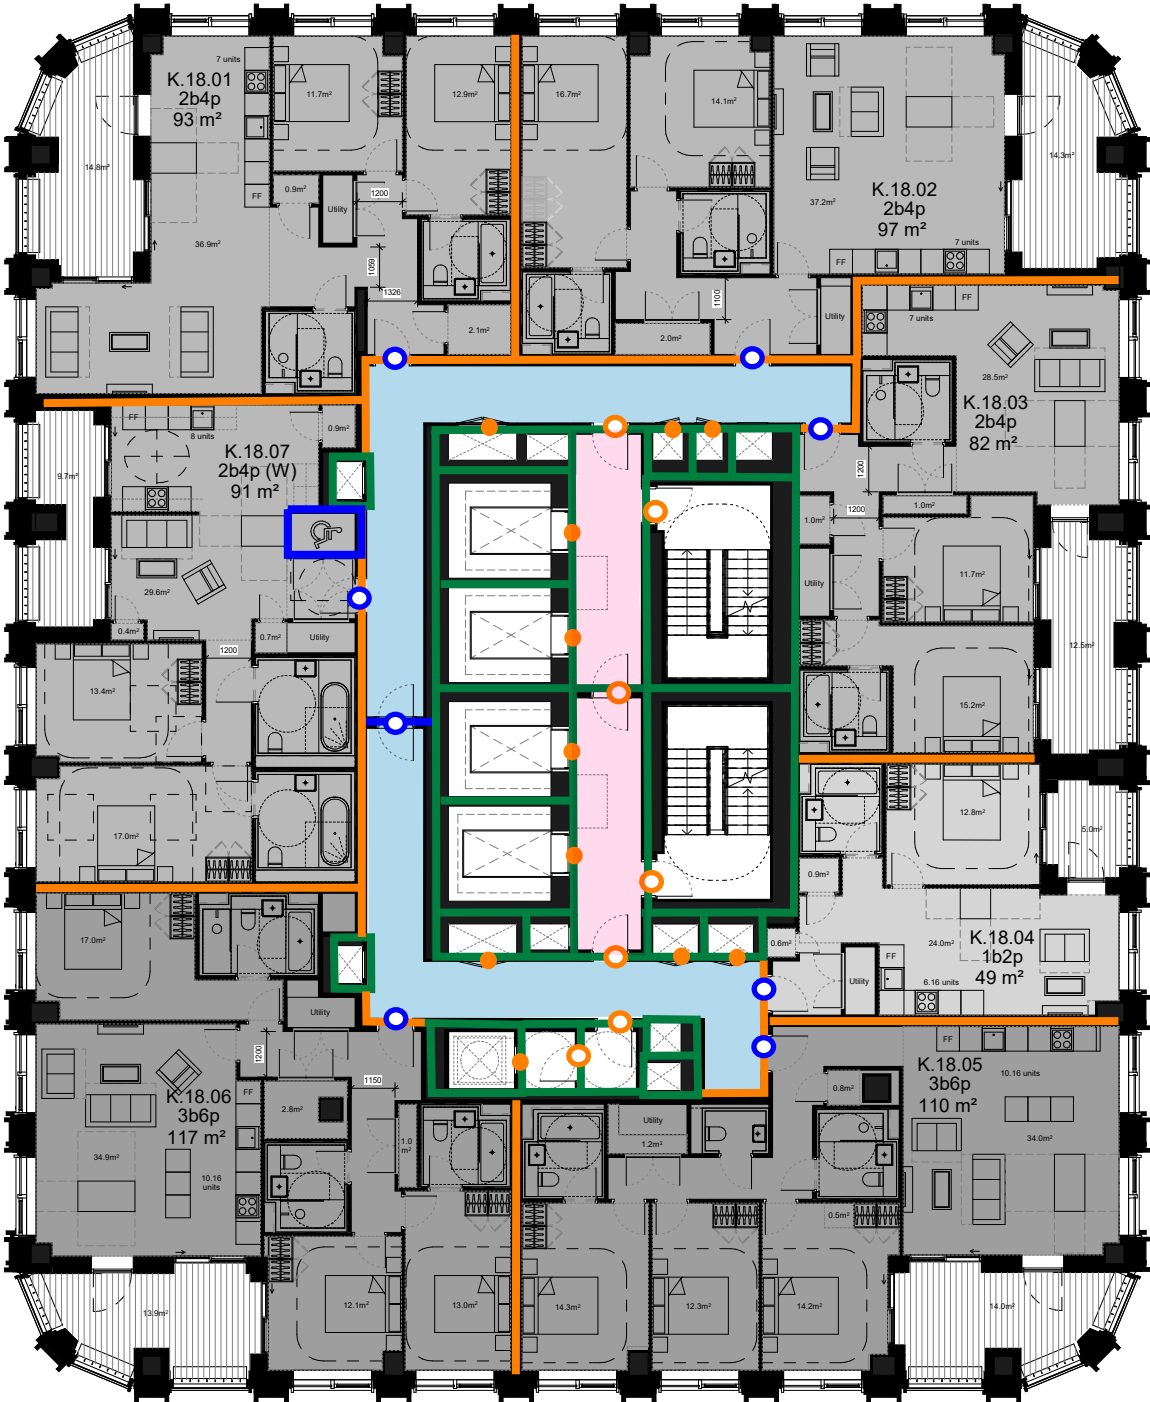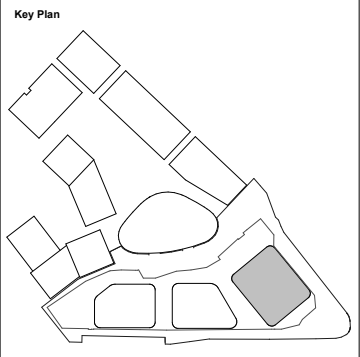



Project
Paddington Green Police Station
London, W2

Title
Block K
Typical 2 - Levels 13-16
Tenure Plan

Suitability	Status	
S2	For Information	
Date	Scale @ ISO A1	Job
22/08/22	1:100	15
Drawing Number		Rev
15044-SQP-03-14-DR-A-20904		P8



All fire safety mark ups are consistent throughout Block K levels.

Annotation	Description
	30 Minutes FR
	60 Minutes FR
	120 Minutes FR
	240 Minutes FR
	FD 30 S Fire Door
	FD 30 Fire Door
	FD 60 S Fire Door
	FD 60 Fire Door
	FD 120 S Fire Door
	FD 120 Fire Door

Issued to Fire Consultant	18/11/22	EJ	P5
Minor updates to areas	18/11/22	EJ	P4
Layouts Changes due to Structural Coordination	14/11/22	EJ	P3
Layouts Changes due to Structural Coordination	13/11/22	EJ	P2
Issued for Information	11/11/22	EJ	P1
Description	Date	Chk	Rev

SQUIRE & PARTNERS

Squire and Partners LLP
The Department Store
248 Ferndale Road, London SW9 8FR
T: 020 7278 5555

info@squireandpartners.com
www.squireandpartners.com



Project
Paddington Green Police Station
London, W2

Title
Block K
Typical 3A - Levels 17-23
Tenure Plan

Suitability Status
S2 For Information

Date Scale @ ISO A1 Job Number
22/08/22 1:100 15044

Drawing Number Revision
15044-SQP-03-ZZ-DR-A-20909 P5

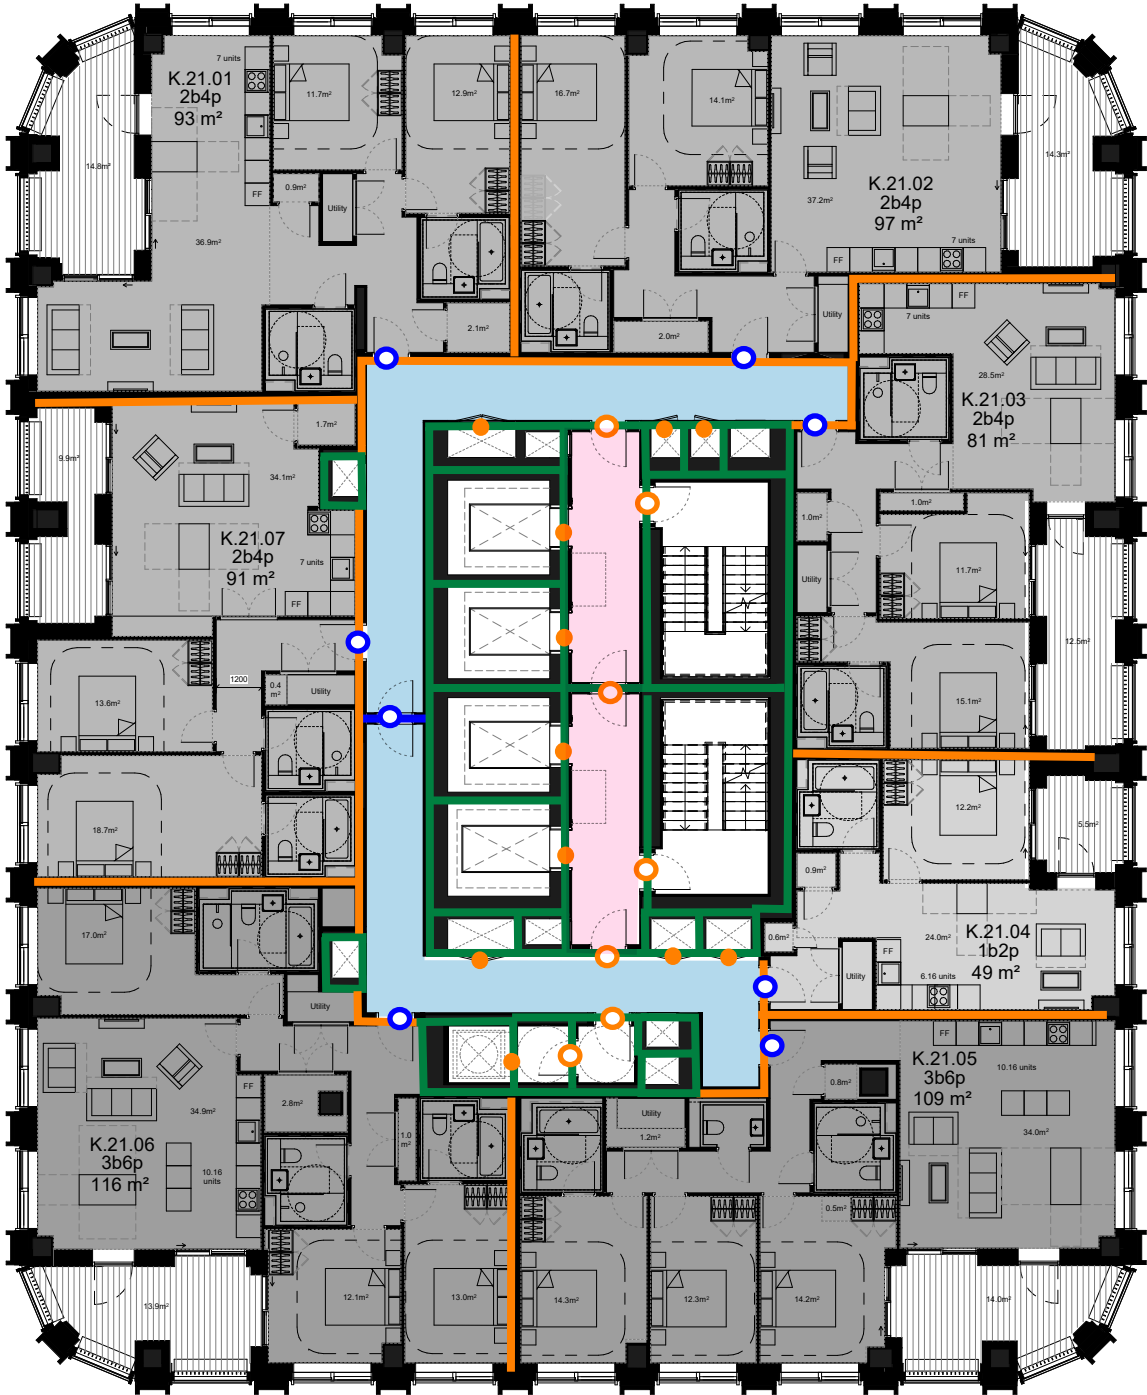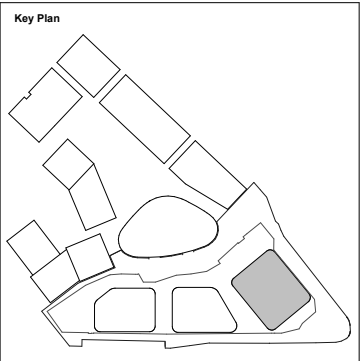

All fire safety mark ups are consistent throughout Block K levels.

Layouts Changes due to Structural Coordination	14/11/22	EJ	P7
Layouts Changes due to Structural Coordination	13/11/22	EJ	P6
Issued for Information	11/11/22	EJ	P5
For Information	10/10/22	EJ	P4
Drawing Ending: 20903 Changed from Typical 2 to Typical 3 (Previously 20904), Levels 19-30	21/09/22	EJ	P3
Amended to Levels 19-28 in Title			
Issued to GLA	16/09/22	EJ	P2
Issued to GLA	07/09/22	EJ	P1
Description	Date	Chk	Rev

SQUIRE & PARTNERS

Squire and Partners LLP
The Department Store
248 Ferndale Road, London SW9 8FR
T: 020 7278 5555
info@squireandpartners.com
www.squireandpartners.com







 



Project
Paddington Green Police Station
London, W2



Title
Block K
Typical 3 - Levels 24-29
Tenure Plan

Suitability Status
S2 For Information

Date Scale @ ISO A1 Job Number
22/08/22 1:100 15044

Drawing Number Revision
15044-SQP-03-ZZ-DR-A-20905 P7

Annotation	Description
	30 Minutes FR
	60 Minutes FR
	120 Minutes FR
	240 Minutes FR
	FD 30 S Fire Door
	FD 30 Fire Door
	FD 60 S Fire Door
	FD 60 Fire Door
	FD 120 S Fire Door
	FD 120 Fire Door

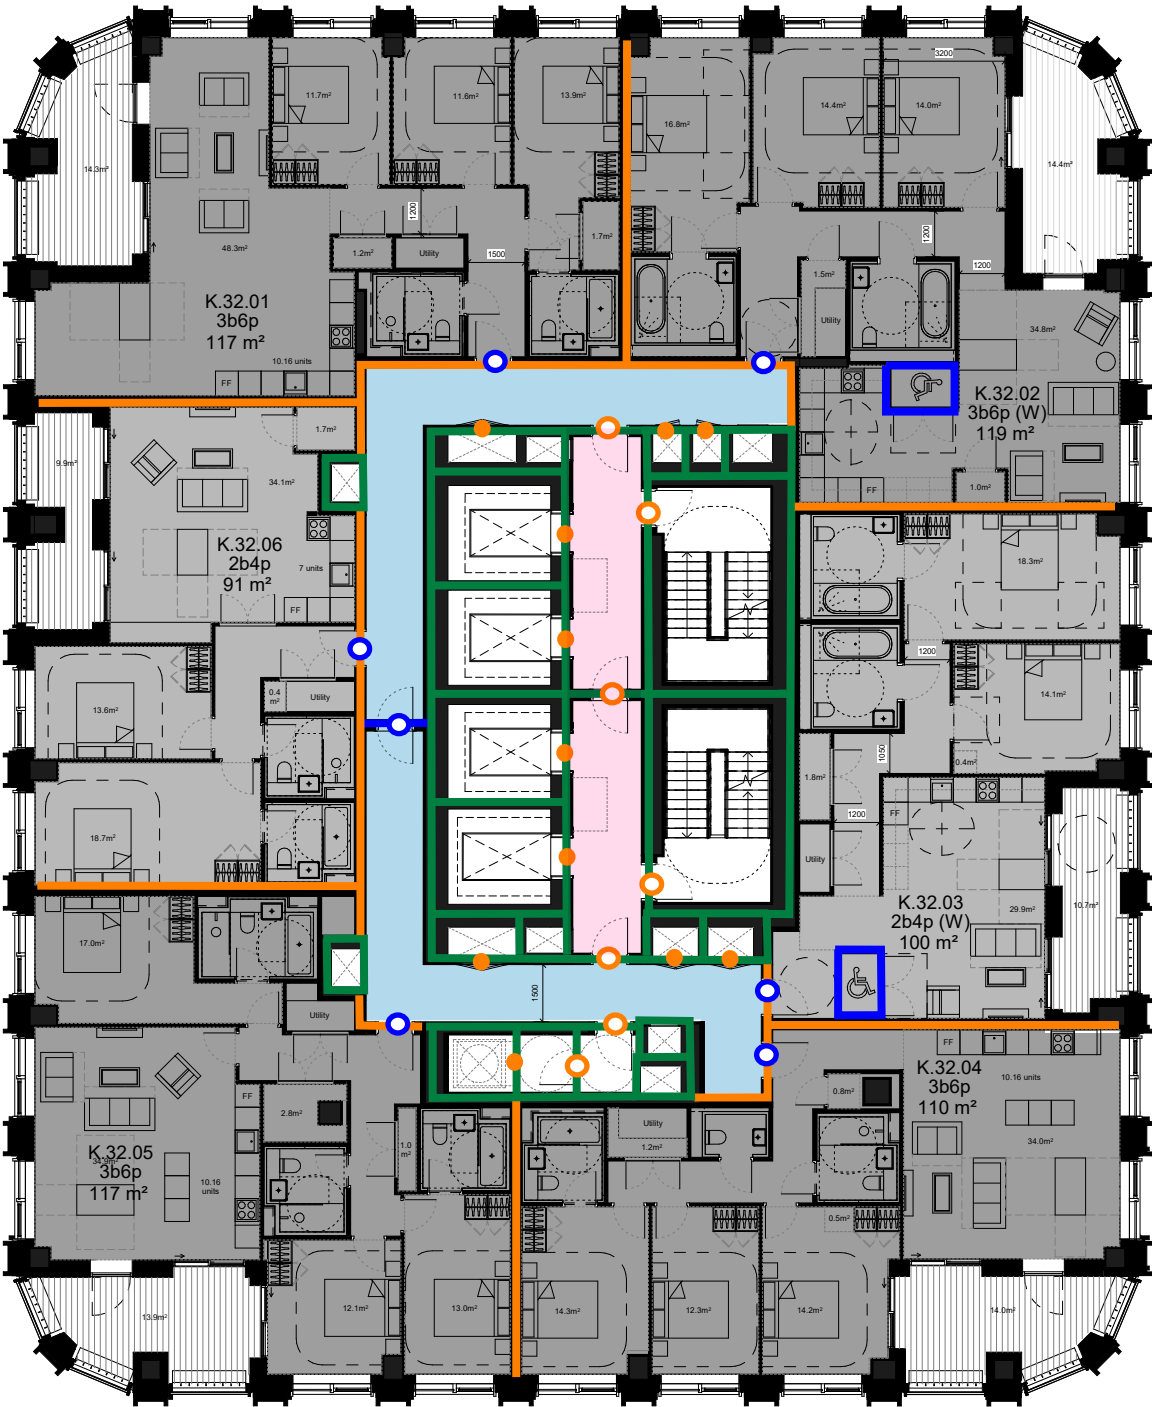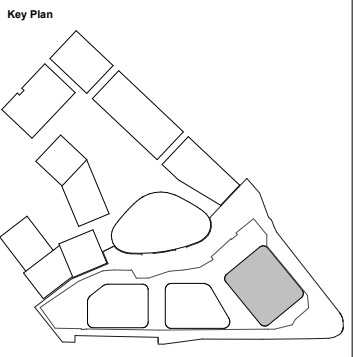

All fire safety mark ups are consistent throughout Block K levels.

Annotation	Description
	30 Minutes FR
	60 Minutes FR
	120 Minutes FR
	240 Minutes FR
	FD 30 S Fire Door
	FD 30 Fire Door
	FD 60 S Fire Door
	FD 60 Fire Door
	FD 120 S Fire Door
	FD 120 Fire Door

Issued to Fire Consultant	18/11/22	EJ	P8
Minor updates to areas	18/11/22	EJ	P7
Layouts Changes due to Structural Coordination	14/11/22	EJ	P6
Layouts Changes due to Structural Coordination	13/11/22	EJ	P5
For Information	10/10/22	EJ	P4
Drawing Ending 20904 Changed from Typical 3 to Typical 4 (Previously 20905), Levels 31-33 & 34-37 Amended to Levels 29-33 in Title	21/09/22	EJ	P3
Levels 34-37 Added in Title (Drawing Ending 20906 - Typical 5 Omitted)	21/09/22	EJ	P2
Issued to GLA	16/09/22	EJ	P1
Description	Date	Chk	Rev



SQUIRE & PARTNERS

Squire and Partners LLP
The Department Store
248 Fendale Road, London SW9 8FR
T: 020 7278 5555
info@squireandpartners.com
www.squireandpartners.com

Project
Paddington Green Police Station
London, W2

Title
Block K
Typical 4 - Levels 30-33
Tenure Plan

Suitability	Status	
S2	For Information	
Date	Scale @ ISO A1	Job Number
12/09/22	1:100	15044
Drawing Number	Revision	
15044-SQP-03-32-DR-A-20906	P8	

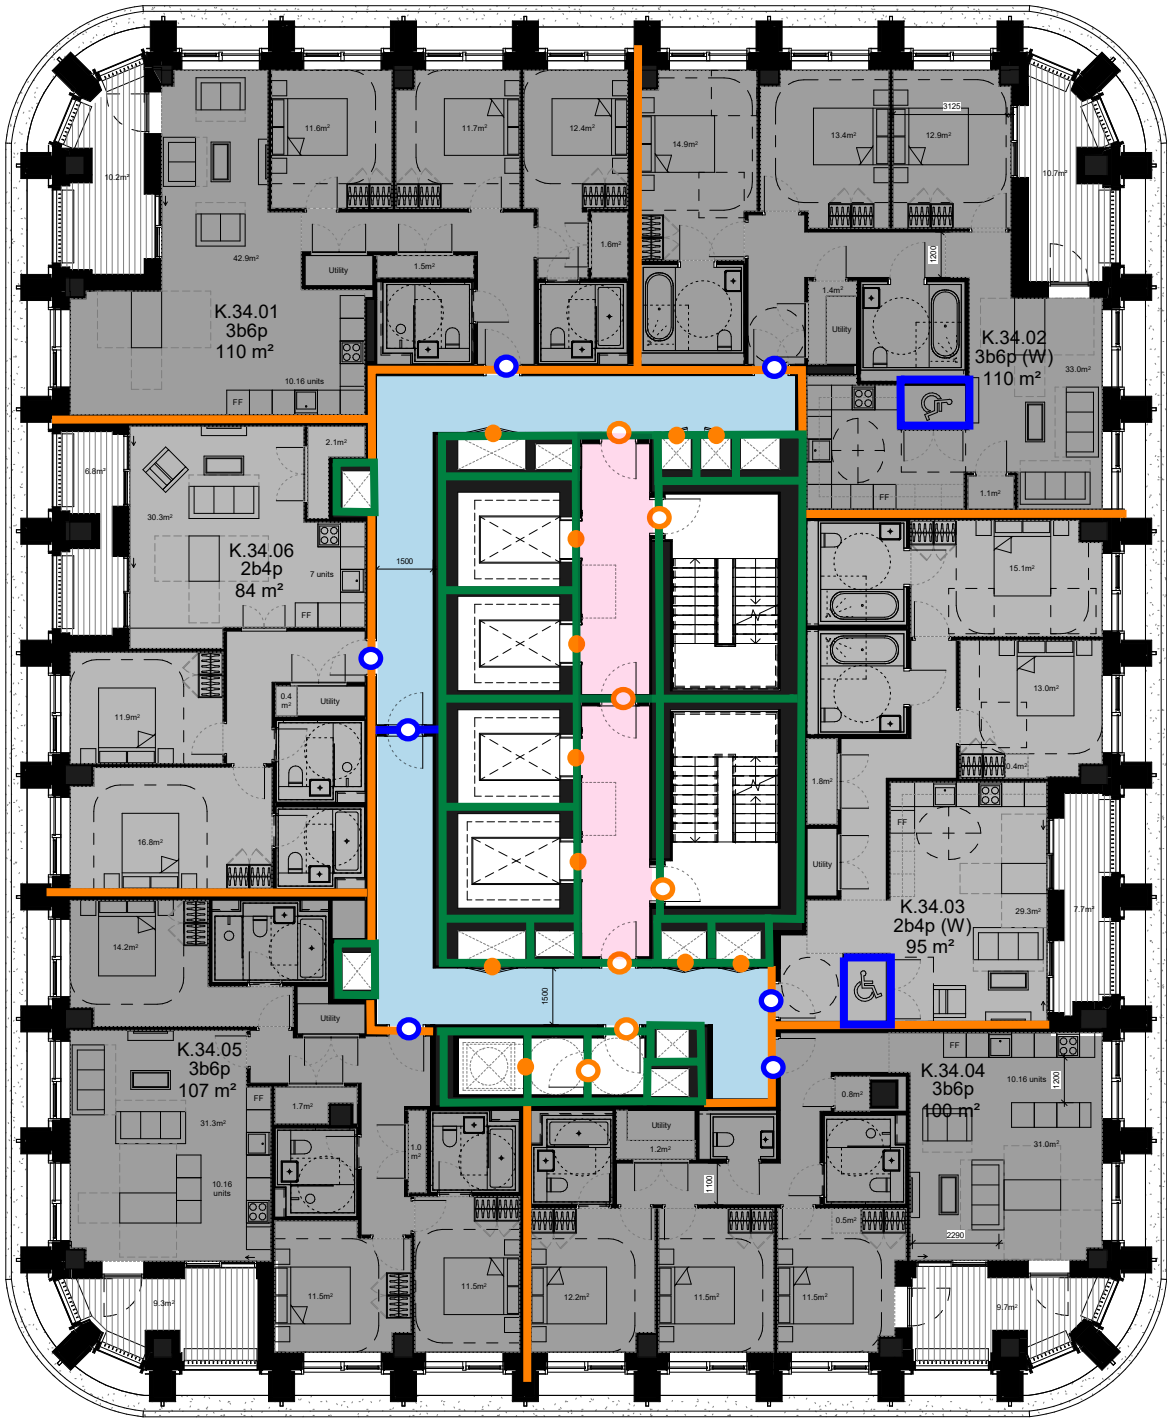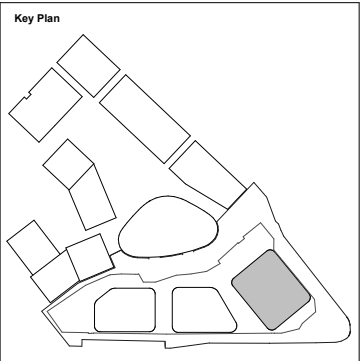

Layouts Changes due to Structural Coordination	14/11/22	EJ	P5
For Information	10/10/22	EJ	P4
Drawing Ending 20905 Changed from Typical 4 to Typical 4A (New Typical), Levels 31-33 & 34-37	21/09/22	EJ	P3
Amended to Levels 34-37 in Title			
Levels 34-37 Added in Title (Drawing Ending 20906 - Typical 5 Omitted)	21/09/22	EJ	P2
Issued to GLA	16/09/22	EJ	P1
Description	Date	Chk	Rev

SQUIRE & PARTNERS

Squire and Partners LLP
The Department Store
248 Ferndale Road, London SW9 8FR
T: 020 7278 5555
info@squireandpartners.com
www.squireandpartners.com

Project
Paddington Green Police Station
London, W2



Title
Block K
Typical 4A - Levels 34-37
Tenure Plan

Suitability Status
S2 For Information

Date Scale @ ISO A1 Job Number
12/09/22 1:100 15044

Drawing Number Revision
15044-SQP-03-34-DR-A-20907 P5

All fire safety mark ups are consistent throughout Block K levels.

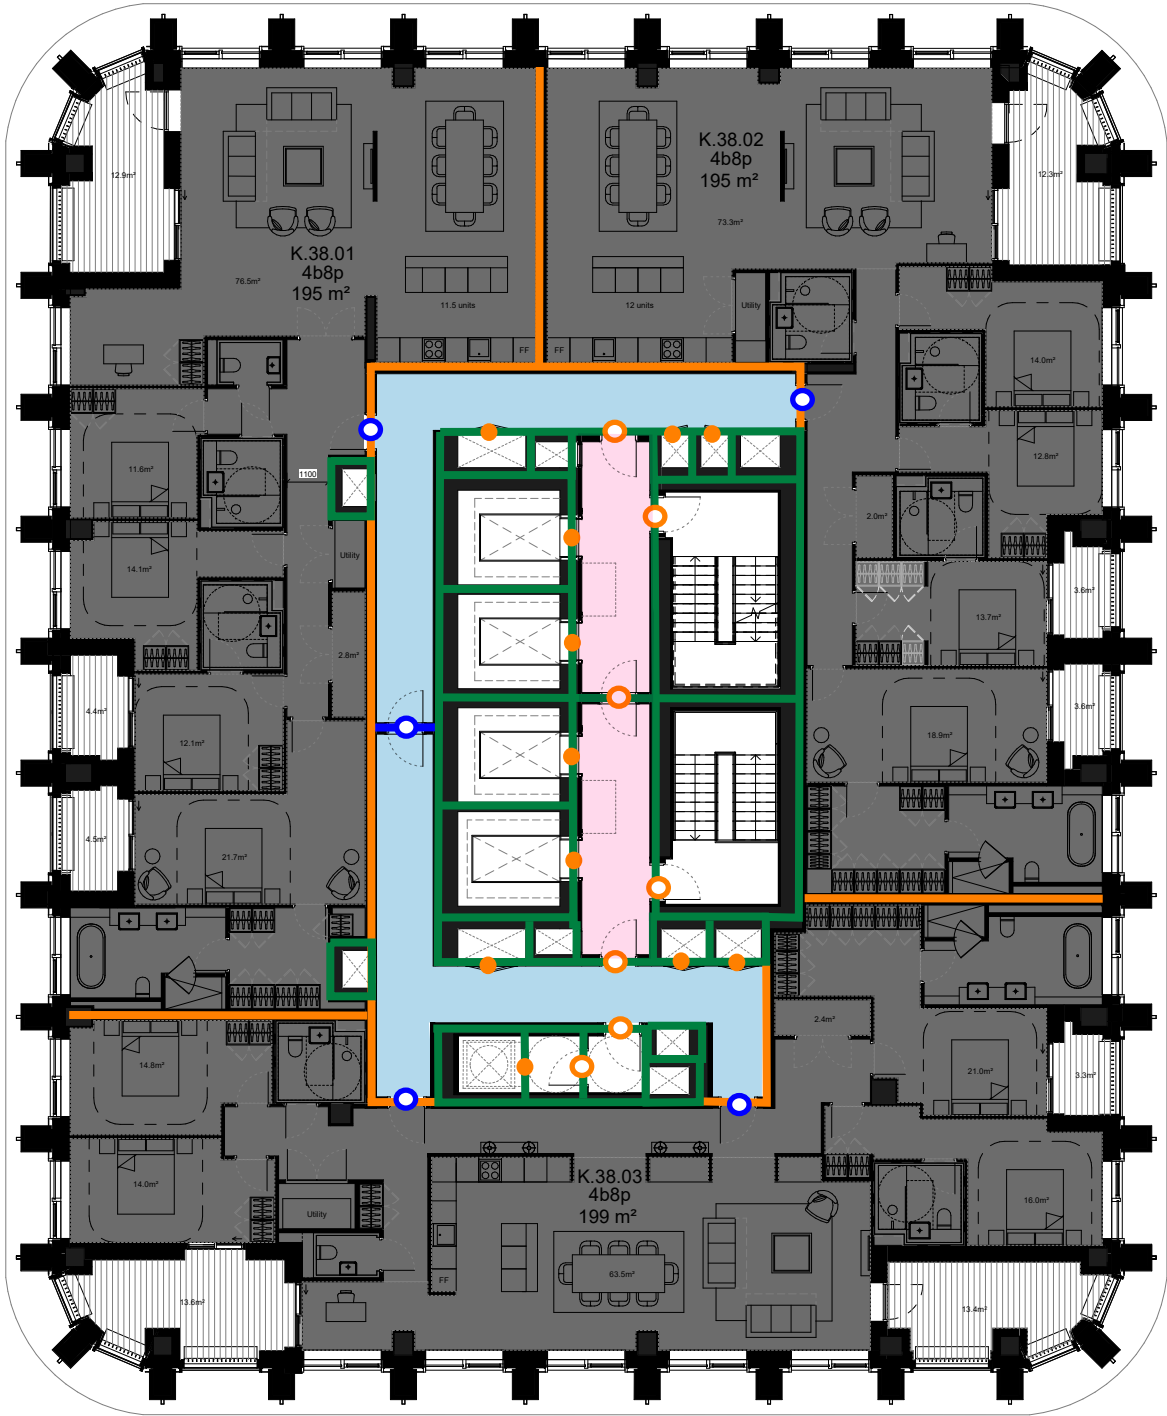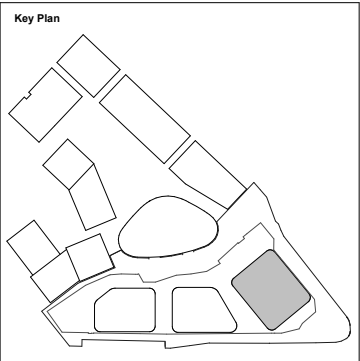

All fire safety mark ups are consistent throughout Block K levels.

Layouts Changes due to Structural Coordination	14/11/22	EJ	P7
Door Moved	11/11/22	EJ	P6
Bedroom Door Moved	07/11/22	EJ	P5
For Information	10/10/22	EJ	P4
Drawing Ending: 20906 Changed from Typical 5 to	21/09/22	EJ	P3
Penthouse (Previously 20907), Levels 34-37			
Amended to Level 38 in Title			
Issued to GLA	16/09/22	EJ	P2
Issued to GLA	07/09/22	EJ	P1
Description	Date	Chk	Rev

SQUIRE & PARTNERS

Squire and Partners LLP
The Department Store
248 Ferndale Road, London SW9 8FR
T: 020 7278 5555
info@squireandpartners.com
www.squireandpartners.com











Project
Paddington Green Police Station
London, W2

Title
Block K
Penthouse - Level 38
Tenure Plan

Suitability Status
S2 For Information

Date Scale @ ISO A1 Job Number
22/08/22 1:100 15044

Drawing Number Revision
15044-SQP-03-38-DR-A-20908 P7

Annotation	Description
	30 Minutes FR
	60 Minutes FR
	120 Minutes FR
	240 Minutes FR
	FD 30 S Fire Door
	FD 30 Fire Door
	FD 60 S Fire Door
	FD 60 Fire Door
	FD 120 S Fire Door
	FD 120 Fire Door