



Pentavia, Mill Hill

London NW7 2ET

Utilities Assessment

Date: 22/03/19

Mantra Services Limited

Covert Farm Barn
Long Lane
East Haddon
NN6 8DU

Tel: 01604 770955

email: mail@mantraservices.co.uk

web: www.mantraservices.co.uk

Site Name	Pentavia Mill
Project Number	716
Client	Long and Partners
Author	Ryan Bell
Date	30/01/15
Revision	1
PAS 128 Survey Level	M1P

Contents

Section 1.....	Survey Details
Section 2.....	Survey Methodology
Section 3.....	Survey Results
Appendix A – Site Survey Metadata	
Appendix B – Site Drawings	
Appendix C – Existing Services	
Appendix D – Agreed Site Survey Area	

Section 1: Survey Details

Site Address	Watford Way Mill Hill London			
Survey Dates	14/01/15 – 16/01/15 19/01/14 – 23/01/15			
Senior Surveyor	Ryan Bell			
Survey Team	Katherine Fawcett	Oliver Pierson		
GPR & EM Equipment Used	RD7000 and RD8000 locators with TX10 Transmitters. Tracer wires and cable clamps were used along with the EM transmitters where applicable.			
	MALA GroundExplorer GPR system			
Site Underlying Soils Type	Slightly acid loamy and clayey soils with impeded drainage			
Weather Conditions	Dry and bright			
Scope of Works	Carry out a utility survey of the excising retail park all of which will be indicated on the drawings in Appendix B both of which where agreed by the client.			

Section 2: Survey methodology

The brief was to locate and trace utilities in the required survey area shown in Appendix D of this document.

The site was surveyed using the trace and grid methods. Firstly all identifiable and visible services were traced with either electromagnetic or GPR methods as appropriate. All accessible chambers are lifted by either manual or mechanical means. Accessible ducts and pipes are located with either a sonde or tracer wire as appropriate. A collection of survey methods is used to provide the best possible result. Depths obtained using geophysical and electromagnetic techniques are affected by ground conditions therefore must be viewed as indicative only. For individual trace quality assessments refer to survey metadata in Appendix A.

The site is then divided into a grid, the transect spacings of which are identified in PAS128:2014 for the level of survey being undertaken, and a sweep is carried out with electromagnetic passive and active methods and GPR to determine the possible locations of non visible and non identifiable services. It is assumed the all services are in straight lines between the grid points.

All radargram data is either interrogated on site or taken away for post processing depending on the level of survey being undertaken and a topographical survey is undertaken for the production of the survey drawing.

Utility identification was carried out via the following methods:

Visual Inspection – Identification from existing features

Existing Utility Plans – Identification from existing service plans as tabulated on submitted service drawings as contained within Appendix B

Where a potential utility could not be identified via either of these methods then they are marked as “Unknown EM” or “Unknown GPR” on the site survey drawing.

100% site coverage is neither offered or guaranteed in carrying out a utility survey. A PAS128:2014 survey Type A – Verification, would be required to achieve this.

Section 3: Survey Results

Every effort was made whilst carrying out the survey to map all known and unknown utilities within the survey area. However we would draw your attention to the following:

- A service indicated on the drawing does not necessarily mean a single service buried.
- A GPR trace could be a non utility object or series of individual buried objects.
- Non invasive survey techniques cannot be guaranteed.
- Trial excavations must be carried out to confirm all site service identification, positions and particularly depths prior to any design or excavations are carried out.
- Accuracy decreases with depth.

General restrictions of non invasive survey techniques:

EM:

- Pot ended and balanced cables and cables to plant using little electricity cannot be traced on passive location.
- Closely coupled services may not be able to be located separately without access for clamps, tracer wires or direct connection.
- Dead cables cut off with no earths and no connection availability cannot be traced.
- Buildings , metal fences and cars cause interference up to 0.5m away
- Non metallic pipes, fibre optic cables, empty ducts and drainage cannot be traced without access for a tracer wire within the service or duct.
- Metallic pipes without access for direct connection may not be traceable

GPR:

- GPR quality and penetration depth can be greatly affected by; soil type, soil moisture content, soil salt content, made up ground, surface type, surface condition and the presence of reinforcement.
- Metal fences, cars, overhead gantries and cables cause radargram interference.
- Dispersion from the top layer of identified services may mask the signals of deeper objects.

Survey Success: GPR

Maximum Penetration Depth	Quality Scale
1.1	4
Comments	

Key – Maximum depth is the depth in metres that the radar effectively penetrated. No GPR data is available below the effective penetration depth.

Quality Scale	GPR Quality Description
1. Good GPR data availability	All utility construction materials should be visible
2. Good to Medium	Some non metallic services may not be visible to radar
3. Medium	Some smaller metallic services may not be visible. Some non metallic services may not be visible
4. Medium to Poor	Some larger metallic services may not be visible. Non metallic services of all sizes may not reflect enough to be visible.
5. High levels of distortion and interference	Information provided by GPR made very little of any material visible.

Survey Success: EM

Survey Success Quality	2
Comments	

Quality Scale	EM Quality Description
1. Good EM data availability	All traceable conductors should be located
2. Good to Medium	Most traceable conductors should be located. Utility density may mean some individual services cannot be isolated
3. Medium to Poor	Medium to high conductor congestion where the isolation of some closely coupled services may not be possible. It should be assumed there are untraceable dead and cut off services in the locality. Known untraceable conductors may be present.
4. High levels of distortion and interference	Heavily congested areas where individual services may not be able to be isolated due to close proximity of many other conductors. Dead and cut off services may be present and untraceable

Abbreviations Used In Documentation

EOT – Trace lost. This is not necessarily the end of the traced target and all EOT locations on the site drawing should be investigated before any design or excavation work is carried out. A target labeled EOT may continue into critical work areas.

R – Service unable to be located and taken from available records. Depths for these are usually unavailable and locations approximate. These should be investigated before any design or excavation work is carried out.

A – Assumed line of utility. Where there is evidence of a utility and two points can be observed but it is unable to be traced an assumed line may be drawn on the site drawing. Depths would be unavailable for assumed lines and they should be investigated before any design or excavation work is carried out.

UTL – Unable to lift. This is where a chamber could not be lifted using either manual or mechanical means.

UTT – Unable to trace. This is used where there is evidence of a utility but it was unable to be located. All UTT services should be investigated before any design or excavation work is carried out.

d/u – Depth Unknown. Used where depth identification was not possible or non conclusive in the survey. All targets marked with this should be investigated before any design or excavation work is carried out.

Surveyors Site Notes

- The following surveyors notes should be read in conjunction with the site drawings contained in Appendix B of this document.
- All note numbers relate to the corresponding numbers on the drawings.

1	Due to compounds being occupied with plant and various items these areas will need a re visit to undertake a full utility survey when units become unoccupied.
2	Area is restricted due to dense vegetation.
3	Chambers were in excess of five meters deep therefore services have been taken from records.
4	From this point services are visible above ground.

Surveyors Conclusions	
Signature	

Every effort should be made to ensure this information is considered in conjunction with the existing survey drawings issued and the survey drawings contained within Appendix B. 100% coverage is neither guaranteed or offered. All persons carrying out excavations or design works should satisfy themselves of all service locations prior to commencement.

Located Utility Summary

Utility	Present	Notes
Gas	Yes	
HV Electricity	Yes	
LV Electricity	Yes	
On Site/Private Electrics, Data etc	Yes	
Unknown GPR	Yes	
Unknown EM	Yes	
Water	Yes	
CCTV	No	
BT	Yes	
Cable	No	
Drainage	Yes	
Overhead	No	

Appendix A – Metadata

Project No	716
Site	Pentavia Mill Hill
Client	Meadow Partners
Survey Dates	

Survey Element Quality Table: Data taken from PAS 128:2014


Quality	Post-processing	Positional Accuracy			Criteria
		Horizontal	Vertical	Criteria	
QL-D	-	Undefined	Undefined	Undefined	Taken from records
QL-C	-	Undefined	Undefined	Undefined	A segment of utility whose location is demonstrated by visual reference to street furniture, topographical features or evidence of previous street works (reinstatement scar)
QL-B4	No	Undefined	Undefined	Undefined	A utility shown on the drawing as assumed
QL-B3	No	+500mm	Undefined No reliable measurement possible	Undefined	Horizontal location only of the utility detected by one of the geophysical techniques used.
QL-B3P	Yes	+500mm	Undefined No reliable measurement possible	Undefined	Horizontal location only of the utility detected by one of the geophysical techniques used.
QL-B2	No	+250mm or 40% of depth whichever is greater	+40% of detected depth	Undefined	Horizontal location only of the utility detected by one of the geophysical techniques used.
QL-B2P	Yes	+250mm or 40% of depth whichever is greater	+40% of detected depth	Undefined	Horizontal location only of the utility detected by one of the geophysical techniques used.
QL-B1	No	+150mm or 15% of detected depth whichever is greater	+15% of detected depth	Undefined	Horizontal location only of the utility detected by one of the geophysical techniques used.
QL-B1P	Yes	+150mm or 15% of detected depth whichever is greater	+15% of detected depth	Undefined	Horizontal location only of the utility detected by one of the geophysical techniques used.

Abbreviations							
HV – High Voltage	LP – Low Pressure	MP – Medium Pressure	HP – High Pressure	C – Concrete	MAT – Pipe Material	TC – Traditional Comms Cable	CATV – Cable Telecommunications
LV – Low Voltage	FO – Fibre Optic	SW – Storm Drainage	G – Gas	FP – Fuel Pipeline	CCTV – Closed Circuit Television	T – BT Telecommunications	RTD – Refer to Drawing
E – Electricity	DU – Empty Duct	FW – Foul Drainage	W – Water		GPR – Unknown GPR Trace	EM – Unknown EM Trace	CA – Compressed Air

Reference	Service	Diameter	Depth	Quality	Nature	Duct Configuration	Owner	Location Method	Records Drawing	Records Date	Notes
M1	E	-	D 0.3-0.64	QL-B2	LV	-	UKPN	EM	-	-	
M2	SW	100MM	D 1.25	QL-B2	CLAY	-	PRIVATE	EM	-	-	
M3	SW	100MM	D 1.25-1.82	QL-B2	CLAY	-	PRIVATE	EM	-	-	
M4	E	-	D 0.48-0.6	QL-B2	HV	-	UKPN	EM	-	-	
M5	E	-	D 0.69-0.9	QL-B2	LV	-	UKPN	EM	-	-	
M6	E	-	D 0.69	QL-B2	LV	-	UKPN	EM	-	-	
M7	SW	150MM	D 1.8-1.9	QL-B2	CLAY	-	PRIVATE	EM	-	-	
M8	FW	150MM	D 0.9	QL-B2	CLAY	-	PRIVATE	EM	-	-	
M9	FW	150MM	D 0.95	QL-B2	CLAY	-	PRIVATE	EM	-	-	
M10	T	100MM	D 0.6	QL-B2	TC/FO	-	BT	EM	-	-	
M11	T	100MM	D 0.42-0.75	QL-B2	TC/FO	-	BT	EM	-	-	
M12	T	100MM	D 0.55-0.7	QL-B2	TC/FO	-	BT	EM	-	-	
M13	T	100MM	D 0.15-0.3	QL-B2	TC/FO	-	BT	EM	-	-	
M14	SW	100MM	D 1.92	QL-B2	CLAY	-	PRIVATE	EM	-	-	
M15	SW	-	-	CLAY	CLAY	-	PRIVATE	-	-	-	
M16	SW	100MM	-	QL-B2	CLAY	-	PRIVATE	EM	-	-	
M17	SW	-	-	QL-B4	CLAY	-	PRIVATE	-	-	-	
M18	SW	225MM	D 1.92	QL-B2	CLAY	-	PRIVATE	EM	-	-	
M19	E	-	D 0.6-0.8	QL-B2	LV	-	UKPN	EM	-	-	
M20	SW	-	D 0.3-1.2	QL-B2	CLAY	-	PRIVATE	EM	-	-	
M21	T	100MM	D 0.34-42	QL-B2	TC/FO	-	PRIVATE	EM	-	-	
M22	SW	-	D 0.8-1.2	QL-B2	CLAY	-	PRIVATE	EM	-	-	
M23	SW	-	D 0.9-1.2	QL-B2	CLAY	-	PRIVATE	EM	-	-	
M24	SW	150MM	D 1.2	QL-B2	CLAY	-	PRIVATE	EM	-	-	
M25	SW	150MM-225MM	D 1.3-2.4	QL-B2	CLAY	-	PRIVATE	EM	-	-	
M26	SW	-	-	QL-B4	CLAY	-	PRIVATE	-	-	-	
M27	SW	300MM	D 2.5	QL-B2	CLAY	-	PRIVATE	EM	-	-	
M28	T	100MM	D 0.8-2.1	QL-B2	TC/FO	-	PRIVATE	EM	-	-	
M29	FW	150MM	D 1.65	QL-B2	CLAY	-	PRIVATE	EM	-	-	
M30	FW	150MM	D 1.45-1.65	QL-B2	CLAY	-	PRIVATE	EM	-	-	
M31	SW	300MM	D 2.1-2.5	QL-B2	CLAY	-	PRIVATE	EM	-	-	
M32	E	-	D 0.52-0.8	QL-B2	LV	-	PRIVATE	EM	-	-	
M33	E	-	-	LV	LV	-	PRIVATE	EM	-	-	
M34	E	-	D 0.35-0.6	QL-B2	LV	-	PRIVATE	EM	-	-	
M35	SW	-	-	CLAY	CLAY	-	PRIVATE	-	-	-	
M36	SW	-	-	CLAY	CLAY	-	PRIVATE	-	-	-	
M37	T	100MM	D 0.25	QL-B2	TC/FO	-	PRIVATE	EM	-	-	
M38	SW	150MM	D 1.1-1.3	QL-B2	CLAY	-	PRIVATE	EM	-	-	
M39	SW	-	D 1.05-1.3	QL-B2	CLAY	-	PRIVATE	EM	-	-	
M40	T	100MM	-	QL-B2	TC/FO	-	PRIVATE	-	-	-	
M41	SW	150MM	D 0.6	QL-B2	CLAY	-	PRIVATE	EM	-	-	
M42	SW	150MM	D 0.6	QL-B2	CLAY	-	PRIVATE	EM	-	-	
M43	SW	150MM	D 0.8	QL-B2	CLAY	-	PRIVATE	EM	-	-	
M44	SW	150MM	D 1.15	QL-B2	CLAY	-	PRIVATE	EM	-	-	
M45	SW	-	-	CLAY	CLAY	-	PRIVATE	-	-	-	
M46	SW	-	-	CLAY	CLAY	-	PRIVATE	-	-	-	
M47	SW	150MM-225MM	D 1.35-2.1	QL-B2	CLAY	-	PRIVATE	EM	-	-	
M48	E	-	D 0.1-0.45	QL-B2	LV	-	PRIVATE	EM	-	-	
M49	FW	150MM	D 0.84	QL-B2	CLAY	-	PRIVATE	EM	-	-	
M50	FW	150MM	D 0.88	QL-B2	CLAY	-	PRIVATE	EM	-	-	
M51	FW	150MM	D 1.75	QL-B2	CLAY	-	PRIVATE	EM	-	-	
M52	FW	150MM	D 0.9-1.75	QL-B2	CLAY	-	PRIVATE	EM	-	-	
M53	FW	150MM	D 0.9	QL-B2	CLAY	-	PRIVATE	EM	-	-	
M54	FW	150MM	D 2.25	QL-B2	CLAY	-	PRIVATE	EM	-	-	
M55	FW	150MM-225MM	D 1.25-2.25	QL-B2	CLAY	-	PRIVATE	EM	-	-	
M56	FW	-	D 1.15	QL-B2	CLAY	-	PRIVATE	EM	-	-	

M57	E	-	D 1.0	QL-B2	LV	-	UKPN	EM
M58	FW	150MM	D 1.25	QL-B2	CLAY	-	PRIVATE	EM
M59	SW	150MM	D 1.0	QL-B2	CLAY	-	PRIVATE	EM
M60	SW	100MM	D 0.2	QL-B2	CLAY	-	PRIVATE	EM
M61	E	-	D 1.0	QL-B2	LV	-	UKPN	EM
M62	SW	150MM	D 1.05	QL-B2	CLAY	-	PRIVATE	EM
M63	FW	150MM	D 1.75	QL-B2	CLAY	-	PRIVATE	EM
M64	W	-	D 0.84	QL-B2	PIPE	-	PRIVATE	EM
M65	E	-	-	-	LV	-	UKPN	EM
M66	SW	100MM	D 2.0	QL-B2	CLAY	-	PRIVATE	EM
M67	SW	600MM	D 2.1	QL-B2	CONCRETE	-	THAMES WATER	EM
M68	SW	100MM	D 2.1	QL-B2	CLAY	-	PRIVATE	EM
M69	SW	450MM	D 2.3	QL-B2	CONCRETE	-	THAMES WATER	EM
M70	SW	225MM	D 2.7	QL-B2	CLAY	-	PRIVATE	EM
M71	SW	300MM	D 2.3-2.65	QL-B2	CONCRETE	-	THAMES WATER	EM
M72	SW	150MM	D 1.1	QL-B2	CLAY	-	PRIVATE	EM
M73	SW	150MM	D 1.1	QL-B2	CLAY	-	PRIVATE	EM
M74	SW	225MM	D 0.25-1.25	QL-B2	CLAY	-	PRIVATE	EM
M75	E	-	D 0.6	QL-B2	LV	-	UKPN	EM
M76	SW	-	D 1.2	QL-B2	CLAY	-	PRIVATE	EM
M77	SW	-	-	-	CLAY	-	PRIVATE	EM
M78	E	-	D 0.74	QL-B2	LV	-	UKPN	EM
M79	SW	300MM-750MM	D 2.0-2.3	QL-B2	CONCRETE	-	THAMES WATER	EM
M80	SW	-	-	-	-	-	-	-
M81	SW	600MM	D 1.7	QL-B2	CONCRETE	-	THAMES WATER	EM
M82	E	-	D 0.32-0.4	QL-B2	-	-	UKPN	EM
M83	FW	100MM	D 1.4	QL-B2	CLAY	-	PRIVATE	EM
M84	FW	150MM	D 1.45-1.5	QL-B2	CLAY	-	PRIVATE	EM
M85	FW	150MM	D 1.5	QL-B2	CLAY	-	PRIVATE	EM
M86	E	-	D 0.15-0.6	QL-B2	LV	-	PRIVATE	EM
M87	W	-	D 0.9-2.0	QL-B2	PIPE	-	THAMES WATER	EM
M88	SW	450MM	D 1.95-2.1	QL-B2	CONCRETE	-	THAMES WATER	EM
M89	SW	-	D 0.6	QL-B2	-	-	PRIVATE	EM
M90	G	-	-	-	PIPE	-	NATIONAL GRID	EM
M91	SW	-	D 0.86-1.65	QL-B2	-	-	PRIVATE	EM
M92	SW	300MM	D 2.1	QL-B2	CONCRETE	-	THAMES WATER	EM
M93	SW	-	D 0.6	QL-B2	-	-	PRIVATE	EM
M94	FW	100MM	D 1.4	QL-B2	CLAY	-	PRIVATE	EM
M95	FW	100MM	D 1.4	QL-B2	CLAY	-	PRIVATE	EM
M96	FW	150MM	D 1.2	QL-B2	CLAY	-	PRIVATE	EM
M97	SW	-	-	-	-	-	PRIVATE	-
M98	SW	-	D 2.0	QL-B2	-	-	PRIVATE	EM
M99	FW	150MM	D 1.2	QL-B2	CLAY	-	PRIVATE	EM
M100	SW	225MM	D 2.0	QL-B2	CLAY	-	PRIVATE	EM
M101	SW	-	D 0.5	QL-B2	CLAY	-	PRIVATE	EM
M102	E	-	-	-	LV	-	UKPN	EM
M103	GPR	-	D 0.7	QL-B2P	-	-	-	-
M104	GPR	-	D 1.5	QL-B2P	-	-	-	-
M105	GPR	-	D 0.97-1.1	QL-B2P	-	-	-	-
M106	GPR	-	D 1.09	QL-B2P	-	-	-	-
M107	GPR	-	D 0.25	QL-B2P	-	-	-	-
M108	E	-	D 0.45-0.65	QL-B2P	LV	-	-	-
M109	GPR	-	D 0.53-0.65	QL-B2P	-	-	-	-
M110	GPR	-	D 1.08-1.2	QL-B2P	-	-	-	-
M111	GPR	-	D 0.66-0.81	QL-B2P	-	-	-	-
M112	GPR	-	D 0.32-0.35	QL-B2P	-	-	-	-
M113	GPR	-	D 0.72-0.87	QL-B2P	-	-	-	-
M114	GPR	-	D 0.5-0.72	QL-B2P	-	-	-	-
M115	GPR	-	D 0.74-0.83	QL-B2P	-	-	-	-
M116	GPR	-	D 0.94-0.98	QL-B2P	-	-	-	-
M117	GPR	-	D 0.49-0.71	QL-B2P	-	-	-	-
M118	GPR	-	D 0.41-0.5	QL-B2P	-	-	-	-
M119	GPR	-	D 0.52-0.54	QL-B2P	-	-	-	-
M120	GPR	-	D 0.69-0.84	QL-B2P	-	-	-	-
M121	GPR	-	D 0.52-0.64	QL-B2P	-	-	-	-
M122	GPR	-	D 0.78	QL-B2P	-	-	-	-
M123	GPR	-	D 0.63-0.85	QL-B2P	-	-	-	-
M124	GPR	-	D 0.58-0.79	QL-B2P	-	-	-	-
M125	GPR	-	D 0.95-0.97	QL-B2P	-	-	-	-
M126	GPR	-	D 0.75	QL-B2P	-	-	-	-
M127	GPR	-	D 0.84-1.06	QL-B2P	-	-	-	-
M128	GPR	-	D 0.52-0.8	QL-B2P	-	-	-	-
M129	GPR	-	D 0.54-0.55	QL-B2P	-	-	-	-
M130	GPR	-	D 0.71-0.79	QL-B2P	-	-	-	-
M131	GPR	-	D 0.67	QL-B2P	-	-	-	-
M132	GPR	-	D 1.33-1.44	QL-B2P	-	-	-	-
M133	GPR	-	D 0.93-1.2	QL-B2P	-	-	-	-
M134	GPR	-	D 0.59-0.93	QL-B2P	-	-	-	-
M135	GPR	-	D 0.72-0.93	QL-B2P	-	-	-	-
M136	GPR	-	D 0.93-1.07	QL-B2P	-	-	-	-

Appendix B – Site Drawings

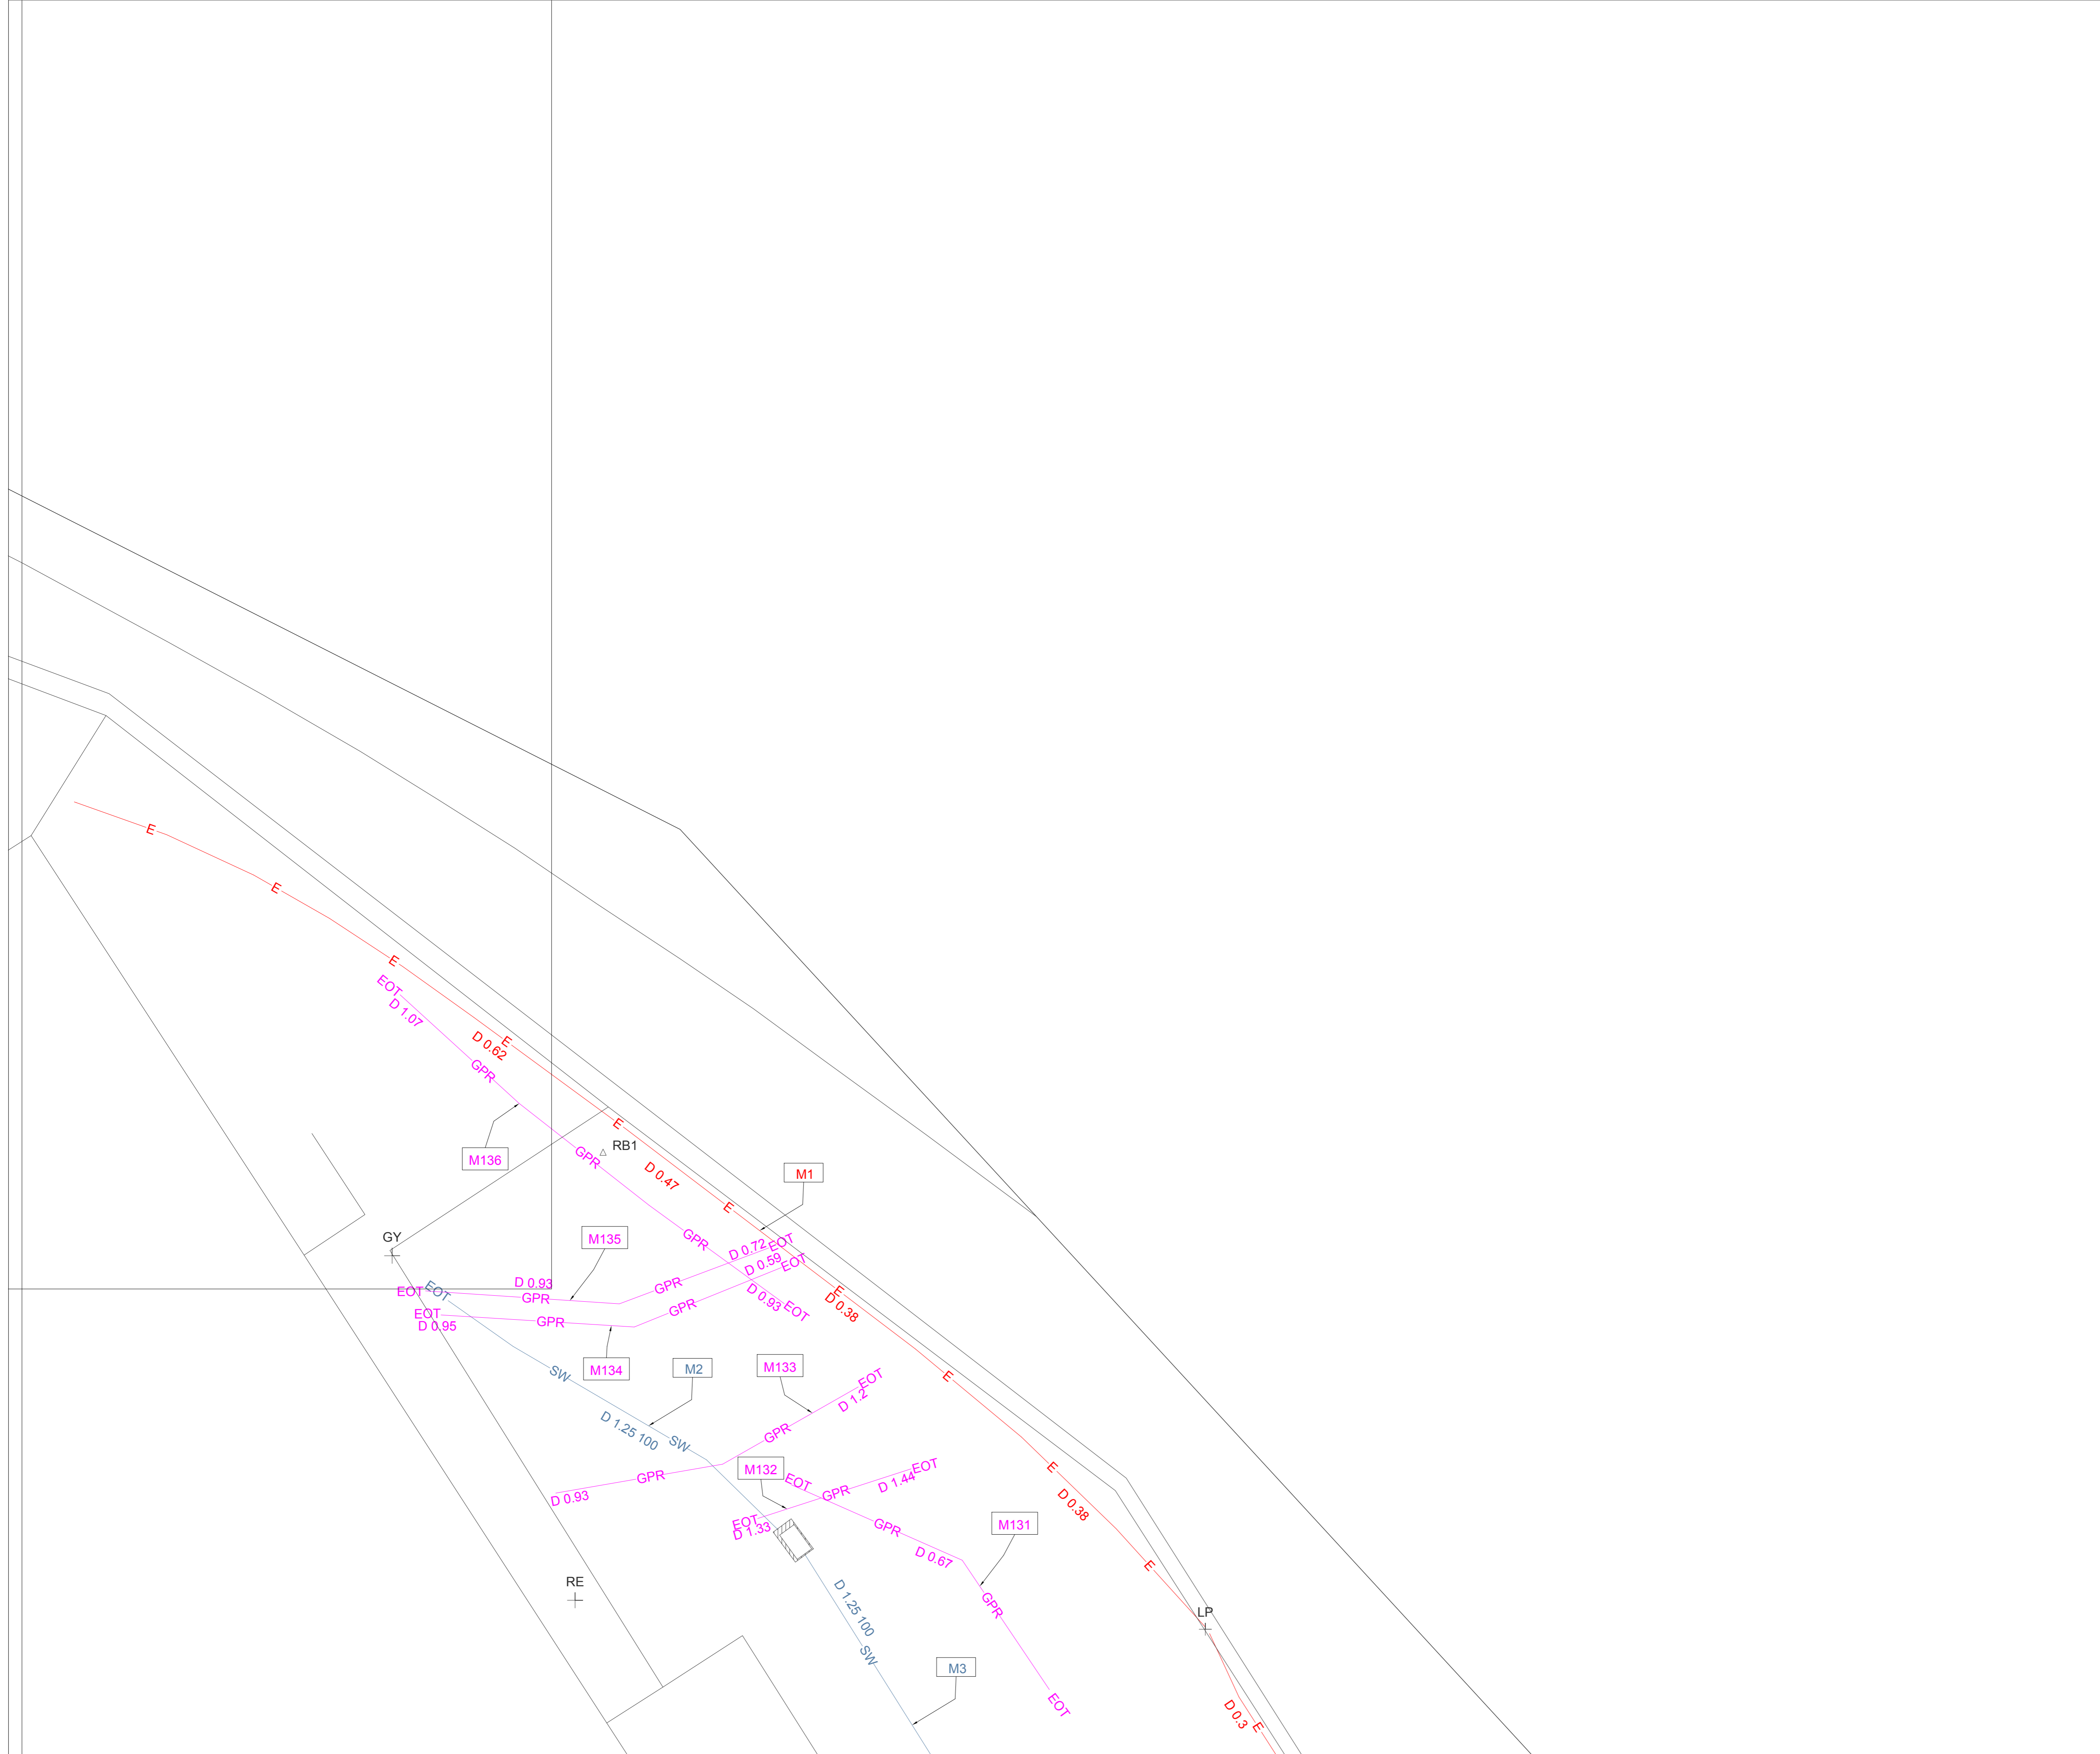

- Notes**
1. This drawing is to be read in conjunction with all relevant specifications, service providers record drawings, RICS Surveys of Land, Buildings and Utility Surveys at Scales of 1:500 and Larger and the surveyors report
 2. This is a composite of two surveys. Where information is from a third party it is unknown which services are taken from records. This should be considered when excavating
 3. Do not scale from this drawing
 4. A single line indicating a service location does not indicate the number of utilities in a location
 5. Electromagnetic and Ground Penetrating Radar methods are employed to compile information on buried services. All data can be effected by external conditions such as ground conditions, interference, soil types, moisture content and ground return currents. All depths should be viewed as indicative and all persons carrying out excavations should satisfy themselves of all service locations prior to commencing works. EM interference occurs within 0.5m of buildings and fences, thus services within this zone may be unable to be traced. GPR is also affected in the proximity of buildings and fences.
 6. Any excavations should be carried out in accordance with HSG47 by trained personnel

Availability of service records

Type	Comments	Type	Comments
Drainage	Refer to survey report appendix C	Gas	Refer to survey report appendix C
Electric	Refer to survey report appendix C	Cable	Refer to survey report appendix C
BT	Refer to survey report appendix C	Pipeline	Refer to survey report appendix C
Water	Refer to survey report appendix C	Other	Refer to survey report appendix C

- | | |
|-------------------------------|----------------------------|
| (A) - Assumed Line | LP - Lamp Column |
| BH - Borehole | MH - Manhole |
| BO - Bollard | MW - Microwave |
| CBL - Concrete Block | OH - Overhead Cable |
| CL - Cable Level | PBC - Push Button Control |
| CTV - Cable TV Point | PID - Intruder Detection |
| D 0.5 - Utility Depth | PO - Post |
| D/U - Depth Unknown | (R) - Utility From Records |
| DIA - Pipe Diameter | RE - Rodding Eye |
| EMP - Electricity Marker Post | RWP - Down Pipe |
| EOT - End of trace | SP - Sign Post |
| (loss of reading) | SV - Stop Valve |
| EP - Electricity Pole | TH - Trial Hole |
| FH - Fire Hydrant | TS - Traffic Signal |
| GMP - Gas Marker Post | UTS - Unable to Survey |
| GV - Gas Valve | UTT - Unable to Trace |
| GY - Gully | UTL - Unable to Lift |
| IB - Illuminated Bollard | VP - Soil & Vent Pipe |
| IC - Inspection Chamber | WMP - Water Marker Post |
| IL - Invert Level | |

- | | |
|-------------------------|--|
| Storm Drainage - SW | GPR Ineffective |
| Foul Drainage - FW | Fence |
| Electricity - E | Important Notes, Refer To Surveyors Report Section 3 |
| Water - W | Metadata, Refer To Surveyors Report Appendix A |
| Gas - G | Extent of Chamber Walls |
| Unknown EM - EM | GPR Anomaly |
| Unknown GPR - GPR | EM Interference |
| Comms - T | |
| Empty Duct - DU | |
| Earth Cable - EA | |
| Utility Survey Boundary | |



1	For Comment	28.01.15
Rev	Amendment	Date



Mantra Services Limited
 Covert Farm Barn, Long Lane, East Haddon NN6 8DU
 Tel: 01604 770955
 mail@mantraservices.co.uk

Client
Meadow Partners

Project Title
Pentavia Mill Hill


Drawing Title
**Pentavia Mill Hill
 Utility Survey Sheet 1**

Drawn By RB	Checked By KF	Approved By AB
-----------------------	-------------------------	--------------------------

Date **28.01.15** Scale **1:100 @ A1**

Purpose
Survey

Drawing Number 716_001	Rev 1
----------------------------------	-----------------

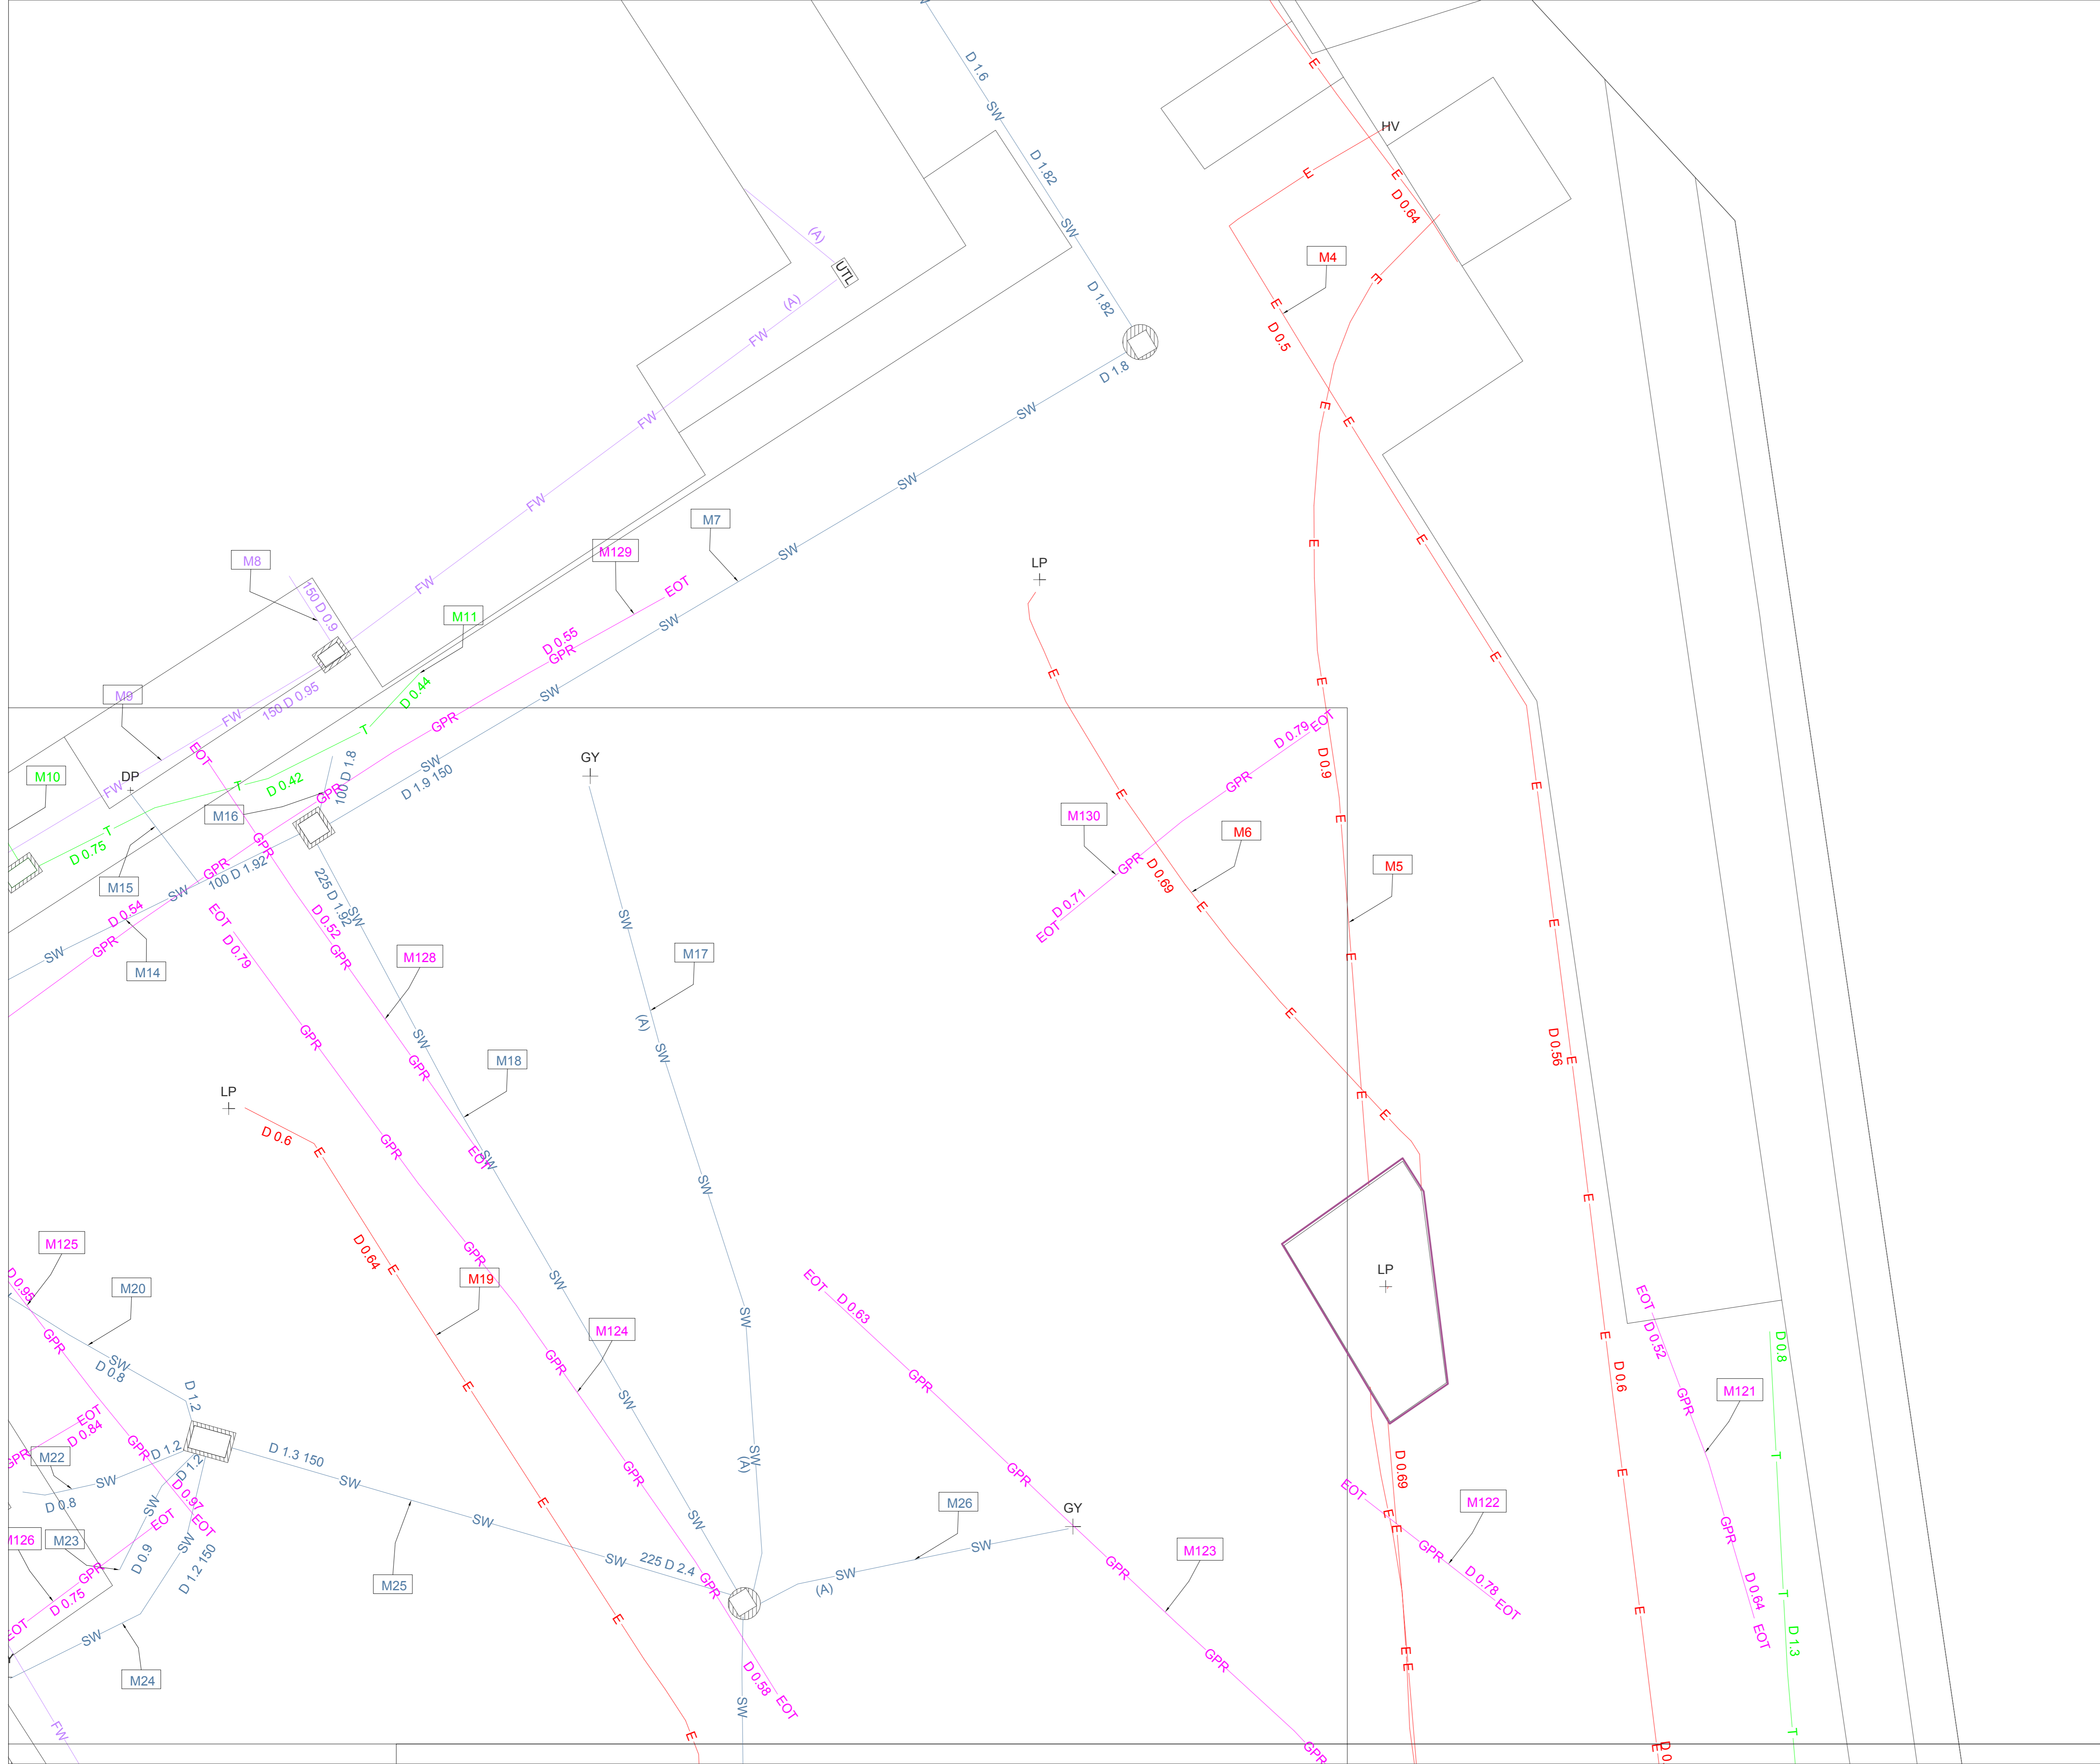

- Notes**
1. This drawing is to be read in conjunction with all relevant specifications, service providers record drawings, RICS Surveys of Land, Buildings and Utility Surveys at Scales of 1:500 and Larger and the surveyors report
 2. This is a composite of two surveys. Where information is from a third party it is unknown which services are taken from records. This should be considered when excavating
 3. Do not scale from this drawing
 4. A single line indicating a service location does not indicate the number of utilities in a location
 5. Electromagnetic and Ground Penetrating Radar methods are employed to complete information on buried services. All data can be effected by external conditions such as ground conditions, interference, soil types, moisture content and ground return currents. All depths should be viewed as indicative and all persons carrying out excavations should satisfy themselves of all service locations prior to commencing works. EM interference occurs within 0.5m of buildings and fences, thus services within this zone may be unable to be traced. GPR is also affected in the proximity of buildings and fences.
 6. Any excavations should be carried out in accordance with HSG47 by trained personnel

Availability of service records

Type	Comments	Type	Comments
Drainage	Refer to survey report appendix C	Gas	Refer to survey report appendix C
Electric	Refer to survey report appendix C	Cable	Refer to survey report appendix C
BT	Refer to survey report appendix C	Pipeline	Refer to survey report appendix C
Water	Refer to survey report appendix C	Other	Refer to survey report appendix C

- (A) - Assumed Line
- BH - Borehole
- BO - Bollard
- CBL - Concrete Block
- CL - Cable Level
- CTV - Cable TV Point
- D 0.5 - Utility Depth
- D/U - Depth Unknown
- DIA - Pipe Diameter
- EMP - Electricity Marker Post
- EOT - End of trace (loss of reading)
- EP - Electricity Pole
- FH - Fire Hydrant
- GMP - Gas Marker Post
- GV - Gas Valve
- GY - Gully
- IB - Illuminated Bollard
- IC - Inspection Chamber
- IL - Invert Level
- LP - Lamp Column
- MH - Manhole
- MW - Microwave
- OH - Overhead Cable
- PBC - Push Button Control
- PID - Intruder Detection
- PO - Post
- (R) - Utility From Records
- RE - Rodding Eye
- RWP - Rod Down Pipe
- SP - Sign Post
- SV - Stop Valve
- TH - Trial Hole
- TS - Traffic Signal
- UTS - Unable to Survey
- UTL - Unable to Lift
- VP - Soil & Vent Pipe
- WMP - Water Marker Post

- Storm Drainage - SW
- Foul Drainage - FW
- Electricity - E
- Water - W
- Gas - G
- Unknown EM - EM
- Unknown GPR - GPR
- Comms - T
- Empty Duct - DU
- Earth Cable - EA
- Utility Survey Boundary
- GPR Ineffective
- Fence
- Important Notes, Refer To Surveyors Report Section 3
- Metadata, Refer To Surveyors Report Appendix A
- Extent of Chamber Walls
- GPR Anomaly
- EM Interference



1	For Comment	28.01.15
Rev	Amendment	Date

Mantra

Mantra Services Limited
 Covert Farm Barn, Long Lane, East Haddon NN6 8DU
 Tel: 01604 770955
 mail@mantraservices.co.uk


Client
Meadow Partners

Project Title
Pentavia Mill Hill

Drawing Title
**Pentavia Mill Hill
 Utility Survey Sheet 2**

Drawn By RB	Checked By KF	Approved By AB
Date 28.01.15	Scale 1:100 @ A1	

Purpose Survey	Drawing Number 716_002	Rev 1
--------------------------	----------------------------------	-----------------

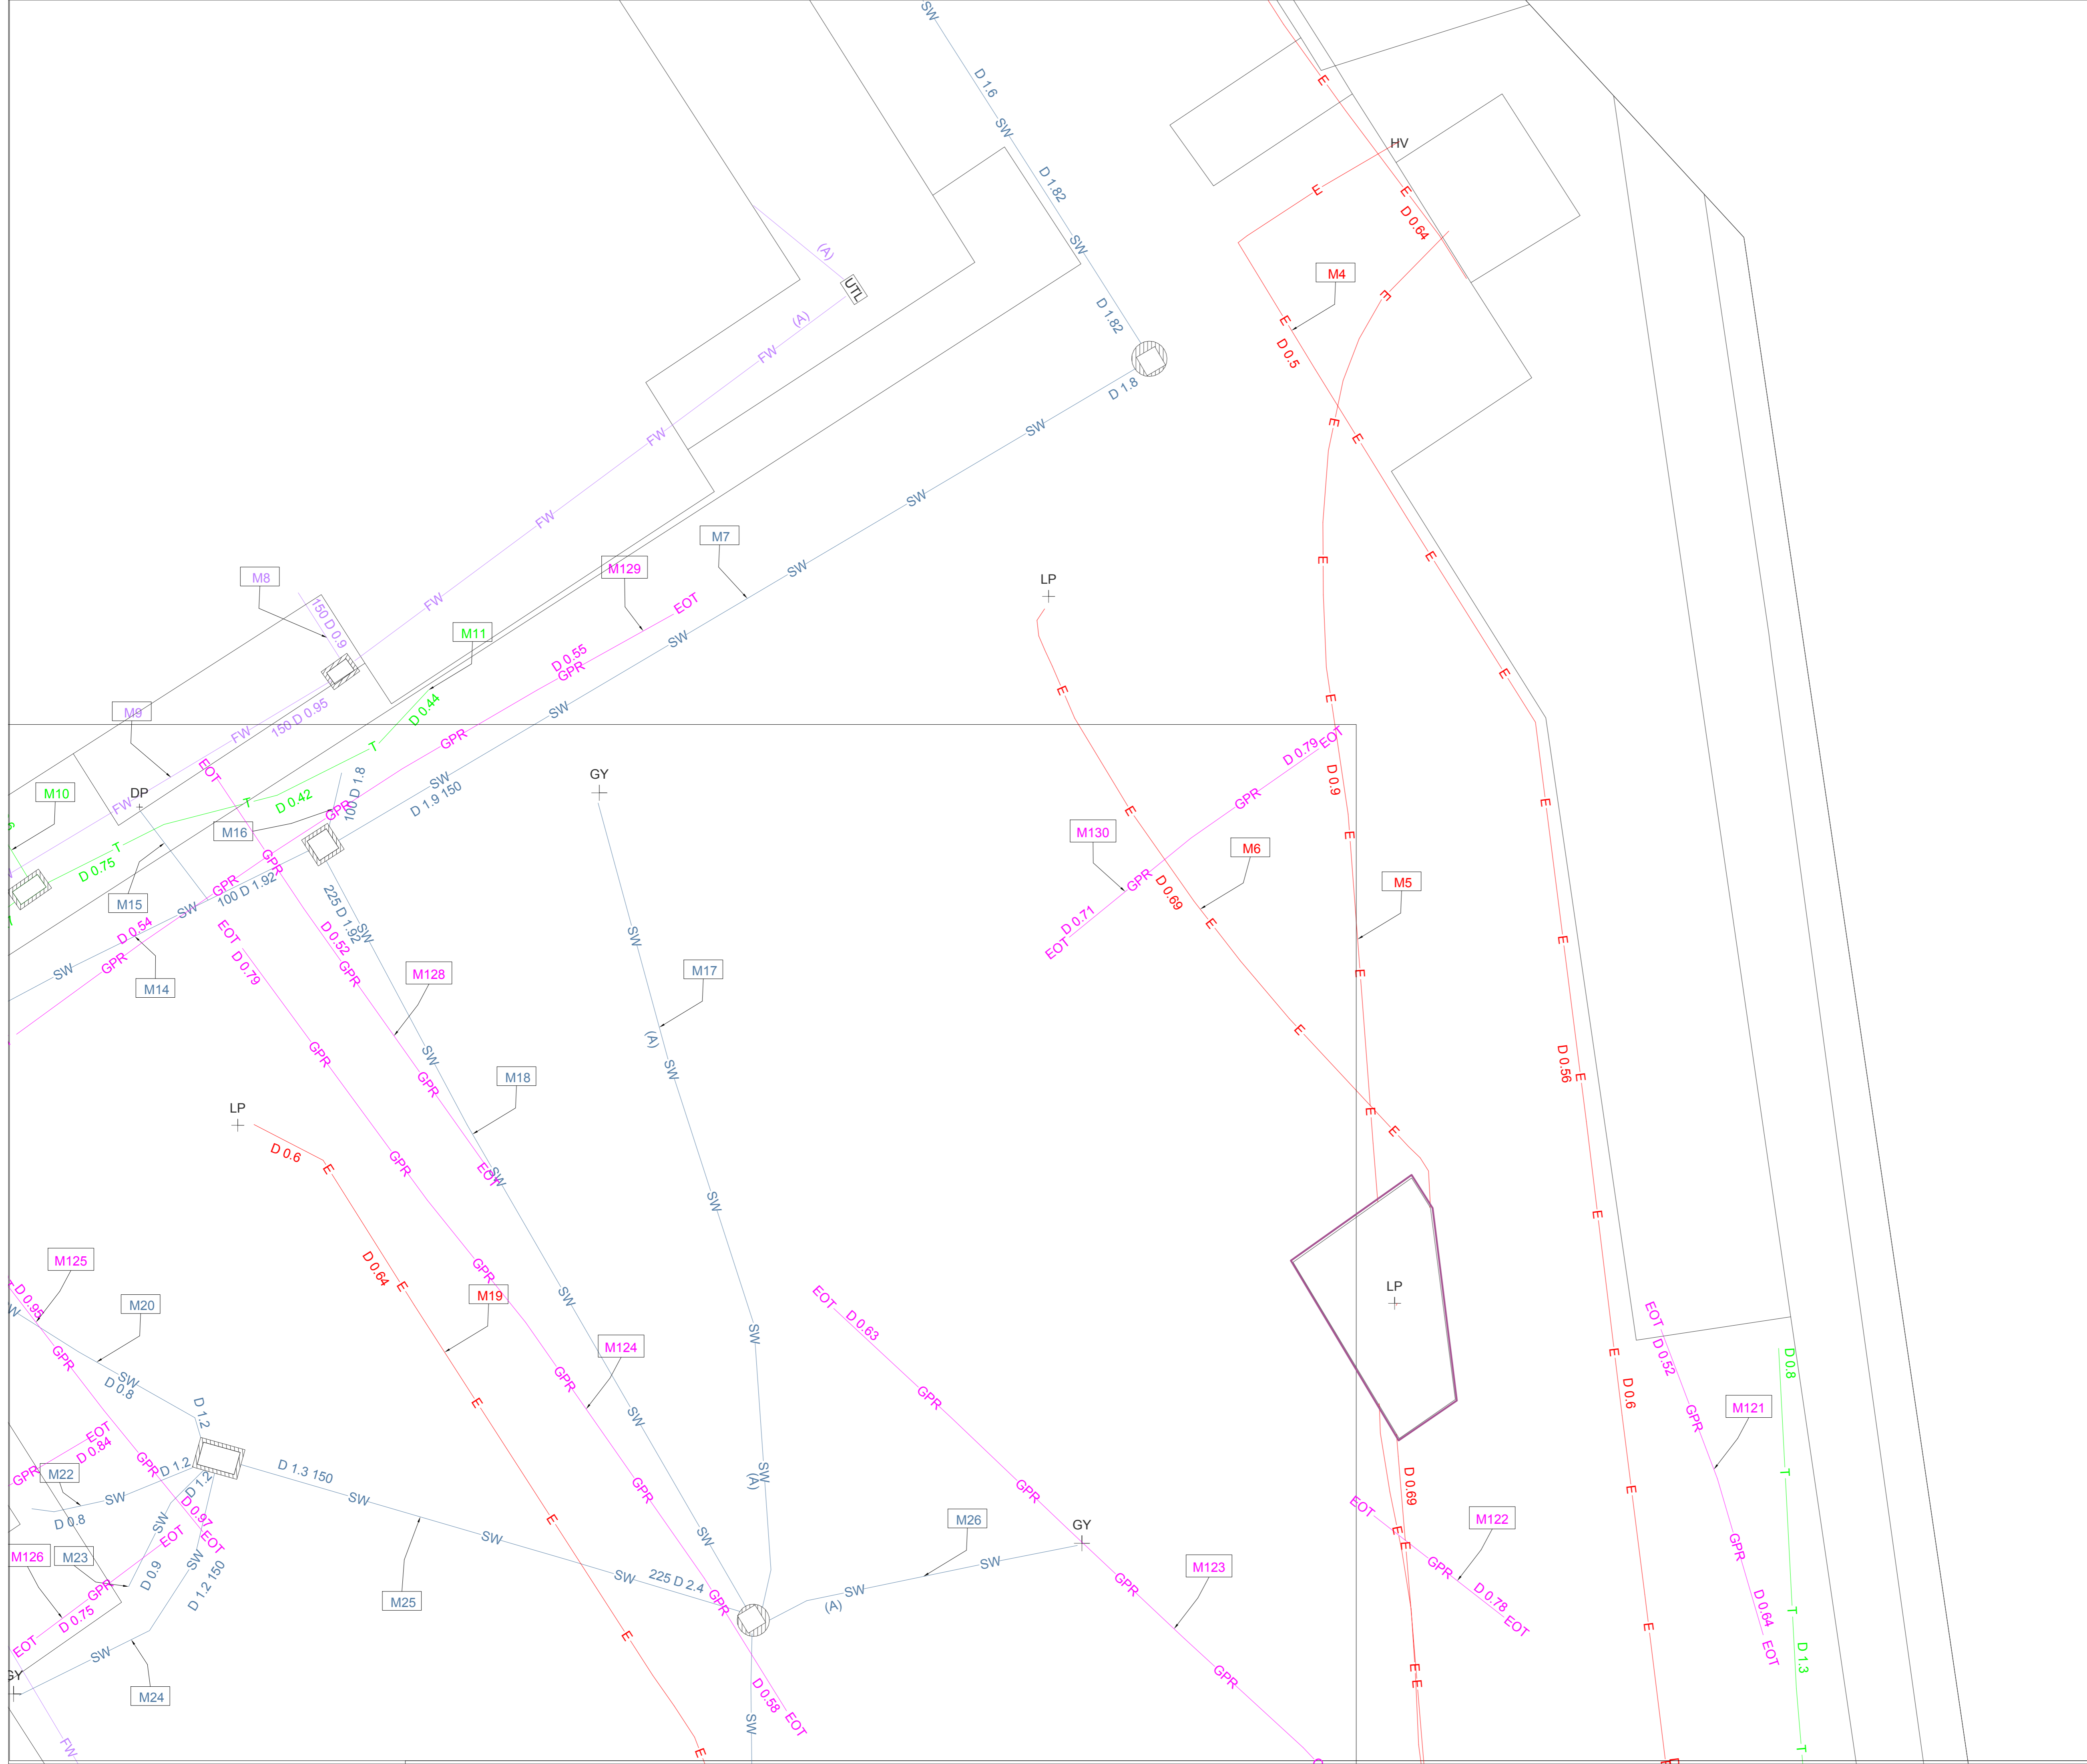

- Notes**
1. This drawing is to be read in conjunction with all relevant specifications, service providers record drawings, RICS Surveys of Land, Buildings and Utility Surveys at Scales of 1:500 and Larger and the surveyors report
 2. This is a composite of two surveys. Where information is from a third party it is unknown which services are taken from records. This should be considered when excavating
 3. Do not scale from this drawing
 4. A single line indicating a service location does not indicate the number of utilities in a location
 5. Electromagnetic and Ground Penetrating Radar methods are employed to complete information on buried services. All data can be effected by external conditions such as ground conditions, interference, soil types, moisture content and ground return currents. All depths should be viewed as indicative and all persons carrying out excavations should satisfy themselves of all service locations prior to commencing works. EM interference occurs within 0.5m of buildings and fences, thus services within this zone may be unable to be traced. GPR is also affected in the proximity of buildings and fences.
 6. Any excavations should be carried out in accordance with HSG47 by trained personnel

Availability of service records

Type	Comments	Type	Comments
Drainage	Refer to survey report appendix C	Gas	Refer to survey report appendix C
Electric	Refer to survey report appendix C	Cable	Refer to survey report appendix C
BT	Refer to survey report appendix C	Pipeline	Refer to survey report appendix C
Water	Refer to survey report appendix C	Other	Refer to survey report appendix C

- (A) - Assumed Line
 BH - Borehole
 BO - Bollard
 CBL - Concrete Block
 CL - Cable Level
 CTV - Cable TV Point
 D 0.5 - Utility Depth
 D/U - Depth Unknown
 DIA - Pipe Diameter
 EMP - Electricity Marker Post
 EOT - End of trace (loss of reading)
 EP - Electricity Pole
 TH - Trial Hole
 GMP - Gas Marker Post
 GV - Gas Valve
 GY - Gully
 IB - Illuminated Bollard
 IC - Inspection Chamber
 IL - Invert Level
- LP - Lamp Column
 MH - Manhole
 MW - Microwave
 OH - Overhead Cable
 PBC - Push Button Control
 PID - Intruder Detection
 PO - Post
 (R) - Utility From Records
 RE - Rodding Eye
 RWP - Rod Down Pipe
 SP - Sign Post
 SV - Stop Valve
 TH - Trial Hole
 TS - Traffic Signal
 UTS - Unable to Trace
 UTT - Unable to Lift
 VP - Soil & Vent Pipe
 WMP - Water Marker Post

- Storm Drainage - SW
 Foul Drainage - FW
 Electricity - E
 Water - W
 Gas - G
 Unknown EM - EM
 Unknown GPR - GPR
 Comms - T
 Empty Duct - DU
 Earth Cable - EA
 Utility Survey Boundary
- GPR Ineffective
 Fence
 Important Notes, Refer To Surveyors Report Section 3
 Metadata, Refer To Surveyors Report Appendix A
 Extent of Chamber Walls
 GPR Anomaly
 EM Interference



Rev	Amendment	Date
1	For Comment	28.01.15

Mantra

Mantra Services Limited
 Covert Farm Barn, Long Lane, East Haddon NN6 8DU
 Tel: 01604 770955
 mail@mantraservices.co.uk

Client
Meadow Partners

Project Title
Pentavia Mill Hill


Drawing Title
**Pentavia Mill Hill
 Utility Survey Sheet 3**

Drawn By **RB** Checked By **KF** Approved By **AB**
 Date **28.01.15** Scale **1:100 @ A1**

Purpose
Survey

Drawing Number
716_003

Rev
1

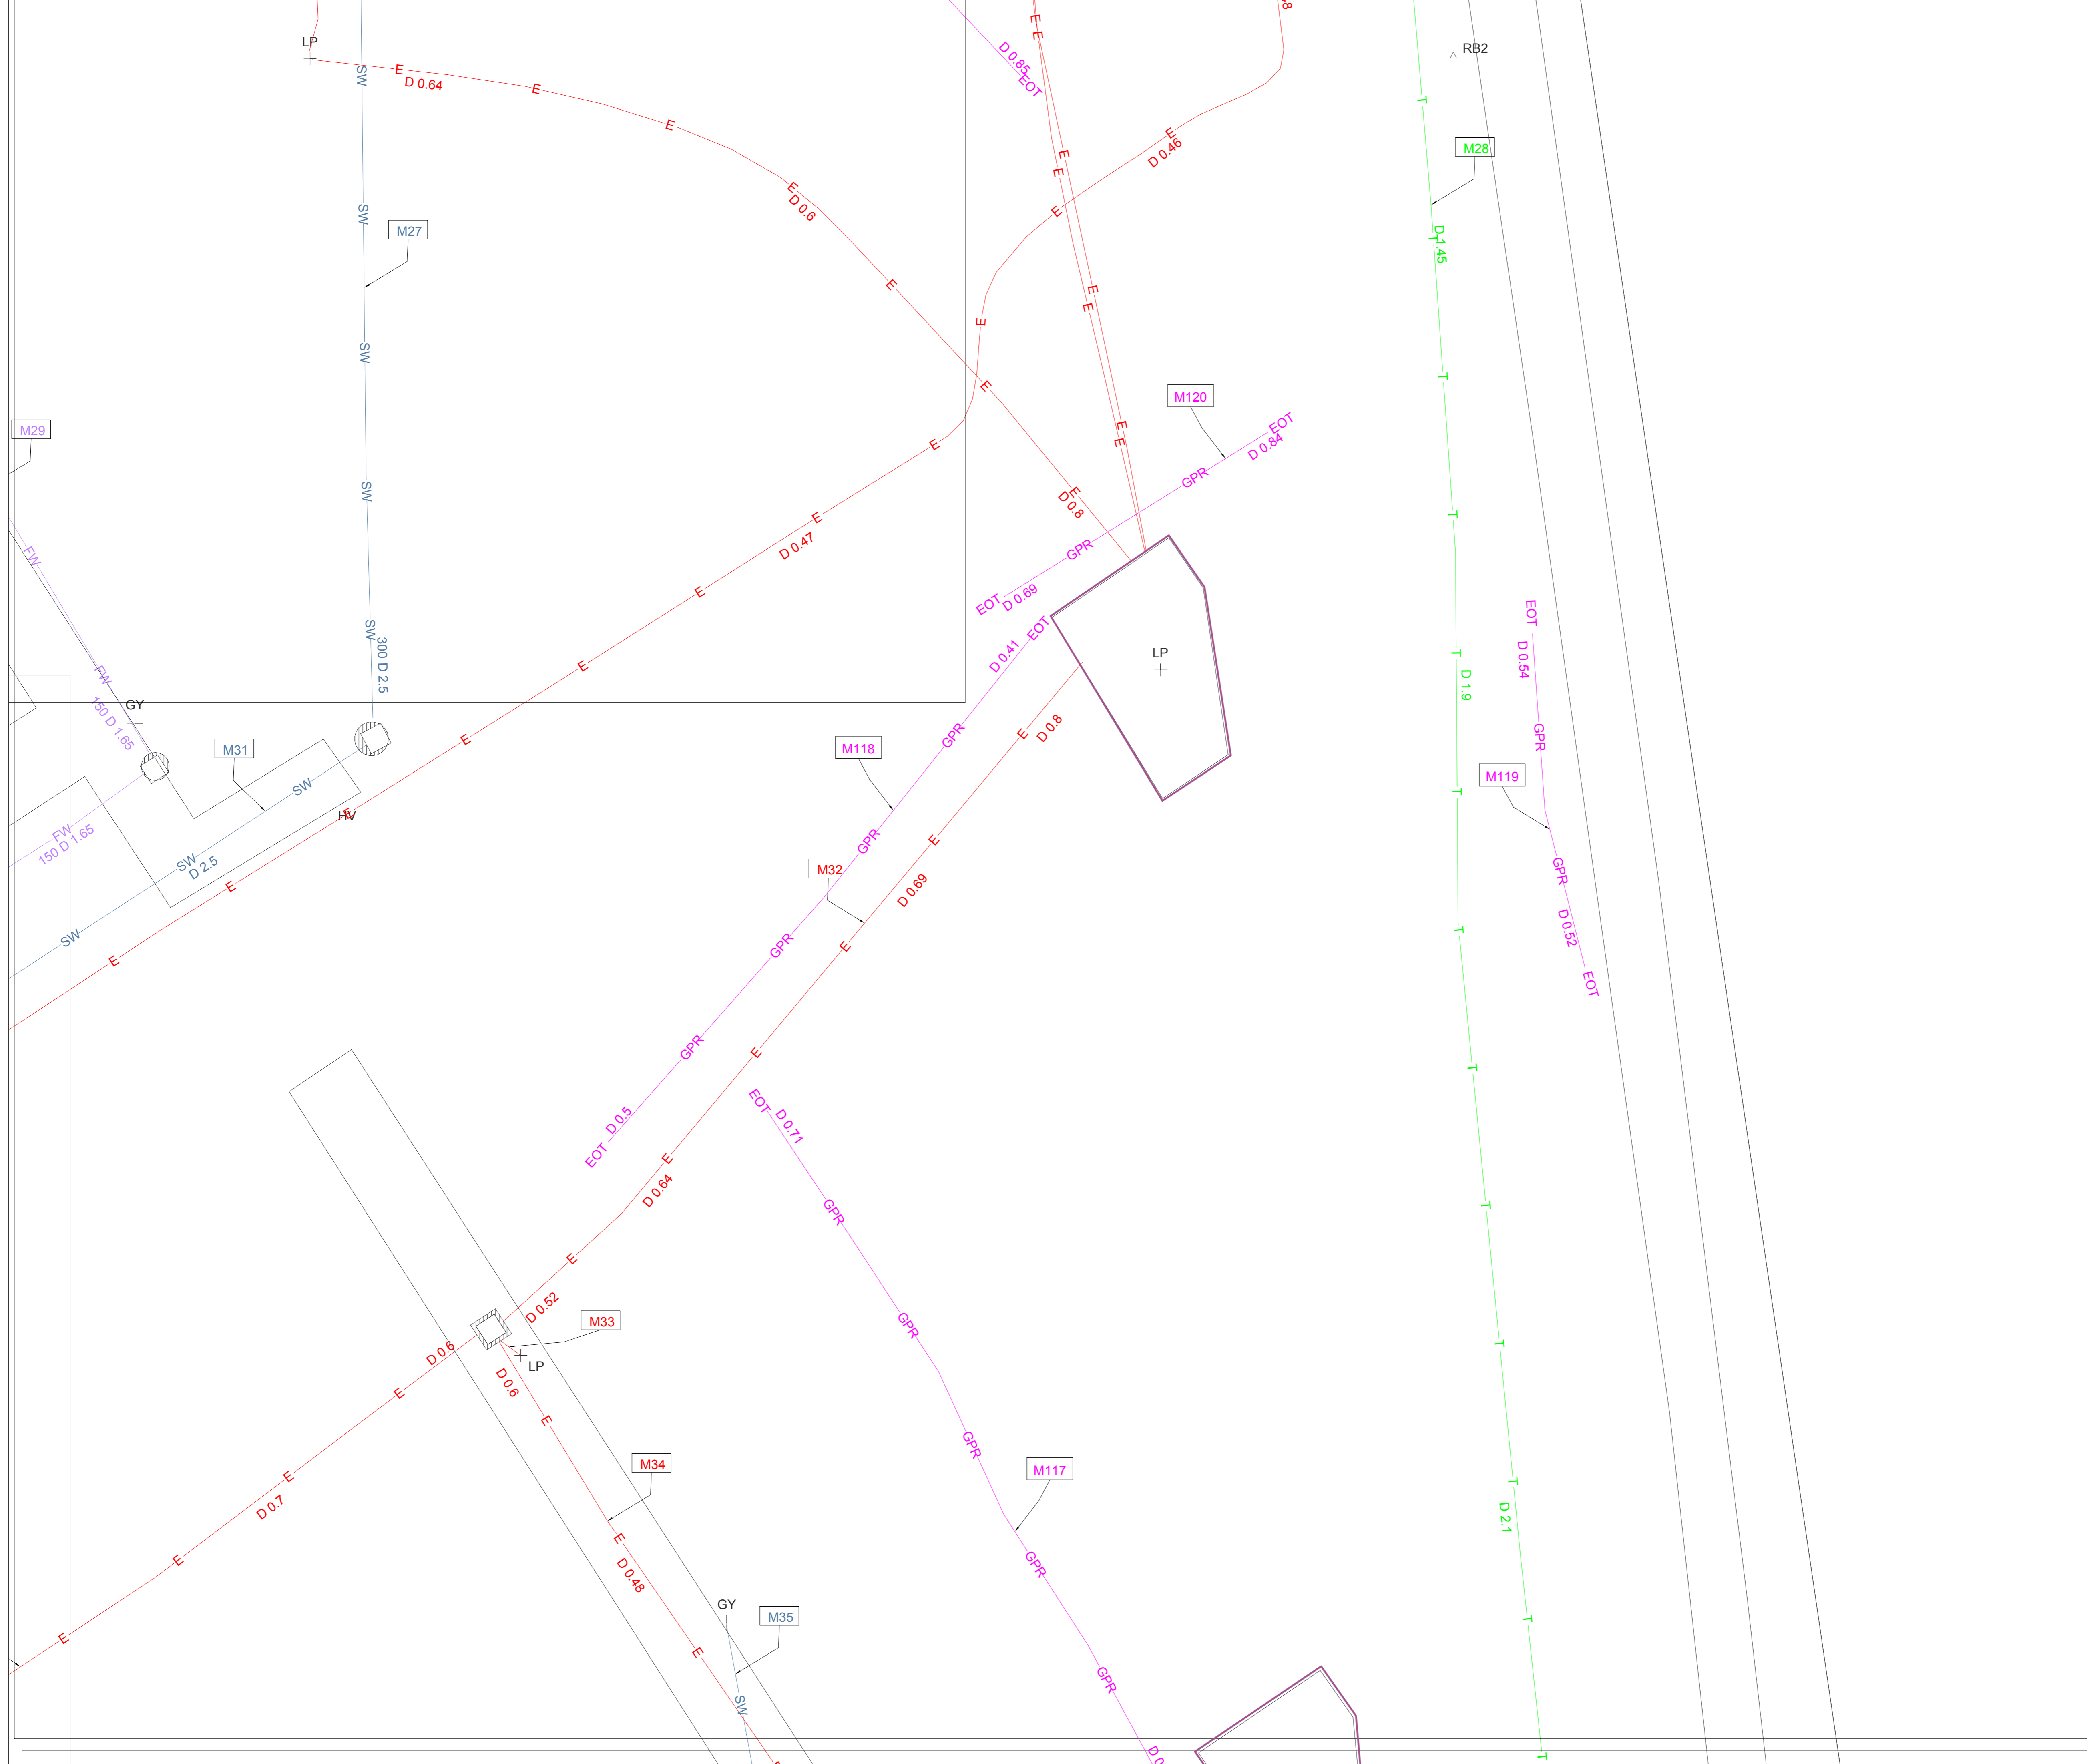

- Notes**
1. This drawing is to be read in conjunction with all relevant specifications, service providers record drawings, RICS Surveys of Land, Buildings and Utility Surveys at Scales of 1:500 and Larger and the surveyors report
 2. This is a composite of two surveys. Where information is from a third party it is unknown which services are taken from records. This should be considered when excavating
 3. Do not scale from this drawing
 4. A single line indicating a service location does not indicate the number of utilities in a location
 5. Electromagnetic and Ground Penetrating Radar methods are employed to complete information on buried services. All data can be effected by external conditions such as ground conditions, interference, soil types, moisture content and ground return currents. All depths should be viewed as indicative and all persons carrying out excavations should satisfy themselves of all service locations prior to commencing works. EM interference occurs within 0.5m of buildings and fences, thus services within this zone may be unable to be traced. GPR is also affected in the proximity of buildings and fences.
 6. Any excavations should be carried out in accordance with HSG47 by trained personnel

Availability of service records

Type	Comments	Type	Comments
Drainage	Refer to survey report appendix C	Gas	Refer to survey report appendix C
Electric	Refer to survey report appendix C	Cable	Refer to survey report appendix C
BT	Refer to survey report appendix C	Pipeline	Refer to survey report appendix C
Water	Refer to survey report appendix C	Other	Refer to survey report appendix C

- | | |
|-------------------------------|----------------------------|
| (A) - Assumed Line | LP - Lamp Column |
| BH - Borehole | MH - Manhole |
| BO - Bollard | MW - Microwave |
| CBL - Concrete Block | OH - Overhead Cable |
| CL - Cable Level | PBC - Push Button Control |
| CTV - Cable TV Point | PID - Intruder Detection |
| D 0.5 - Utility Depth | PO - Post |
| D/U - Depth Unknown | (R) - Utility From Records |
| DIA - Pipe Diameter | RE - Rodding Eye |
| EMP - Electricity Marker Post | RWP - Down Pipe |
| EOT - End of trace | SP - Sign Post |
| (loss of reading) | SV - Stop Valve |
| EP - Electricity Pole | TH - Trial Hole |
| FH - Fire Hydrant | TS - Traffic Signal |
| GMP - Gas Marker Post | UTS - Unable to Survey |
| GV - Gas Valve | UTT - Unable to Trace |
| GY - Gully | UTL - Unable to Lift |
| IB - Illuminated Bollard | VP - Soil & Vent Pipe |
| IC - Inspection Chamber | WMP - Water Marker Post |
| IL - Invert Level | |

- | | |
|---------------------------|--|
| Storm Drainage - SW | GPR Ineffective - |
| Foul Drainage - FW | Fence - x x x x |
| Electricity - E | Important Notes, Refer To Surveyors Report Section 3 |
| Water - W | Metadata, Refer To Surveyors Report Appendix A |
| Gas - G | Extent of Chamber Walls |
| Unknown EM - EM | GPR Anomaly |
| Unknown GPR - GPR | EM Interference |
| Comms - T | |
| Empty Duct - DU | |
| Earth Cable - EA | |
| Utility Survey Boundary - | |



1	For Comment	28.01.15
Rev	Amendment	Date



Mantra Services Limited
 Covert Farm Barn, Long Lane, East Haddon NN6 8DU
 Tel: 01604 770955
 mail@mantraservices.co.uk

Client
Meadow Partners

Project Title
Pentavia Mill Hill

Drawing Title
**Pentavia Mill Hill
 Utility Survey Sheet 4**

Drawn By RB	Checked By KF	Approved By AB
Date 28.01.15	Scale 1:100 @ A1	
Purpose Survey		

Drawing Number 716_004	Rev 1
----------------------------------	-----------------



- Notes
1. This drawing is to be read in conjunction with all relevant specifications, service providers record drawings, RICS Surveys of Land, Buildings and Utility Surveys at Scales of 1:500 and Larger and the surveyors report
 2. This is a composite of two surveys. Where information is from a third party it is unknown which services are taken from records. This should be considered when excavating
 3. Do not scale from this drawing
 4. A single line indicating a service location does not indicate the number of utilities in a location
 5. Electromagnetic and Ground Penetrating Radar methods are employed to complete information on buried services. All data can be effected by external conditions such as ground conditions, interference, soil types, moisture content and ground return currents. All depths should be viewed as indicative and all persons carrying out excavations should satisfy themselves of all service locations prior to commencing works. EM interference occurs within 0.5m of buildings and fences, thus services within this zone may be unable to be traced. GPR is also affected in the proximity of buildings and fences.
 6. Any excavations should be carried out in accordance with HSG47 by trained personnel

Availability of service records

Type	Comments	Type	Comments
Drainage	Refer to survey report appendix C	Gas	Refer to survey report appendix C
Electric	Refer to survey report appendix C	Cable	Refer to survey report appendix C
BT	Refer to survey report appendix C	Pipeline	Refer to survey report appendix C
Water	Refer to survey report appendix C	Other	Refer to survey report appendix C

- (A) - Assumed Line
- BH - Borehole
- BO - Bollard
- CBL - Concrete Block
- CL - Cable Level
- CTV - Cable TV Point
- D 0.5 - Utility Depth
- D/U - Depth Unknown
- DIA - Pipe Diameter
- EMP - Electricity Marker Post
- EOT - End of trace (loss of reading)
- EP - Electricity Pole
- FH - Fire Hydrant
- GMP - Gas Marker Post
- GV - Gas Valve
- GY - Gully
- IB - Illuminated Bollard
- IC - Inspection Chamber
- IL - Invert Level
- LP - Lamp Column
- MH - Manhole
- MW - Microwave
- OH - Overhead Cable
- PBC - Push Button Control
- PID - Intruder Detection
- PO - Post
- (R) - Utility From Records
- RE - Rodding Eye
- RWP - Down Pipe
- SP - Sign Post
- SV - Stop Valve
- TH - Trial Hole
- TS - Traffic Signal
- UTS - Unable to Survey
- UTT - Unable to Trace
- UTL - Unable to Lift
- VP - Soil & Vent Pipe
- WMP - Water Marker Post

- Storm Drainage - SW
- Foul Drainage - FW
- Electricity - E
- Water - W
- Gas - G
- Unknown EM - EM
- Unknown GPR - GPR
- Comms - T
- Empty Duct - DU
- Earth Cable - EA
- Utility Survey Boundary
- GPR Ineffective
- Fence
- Important Notes, Refer To Surveyors Report Section 3
- Metadata, Refer To Surveyors Report Appendix A
- Extent of Chamber Walls
- GPR Anomaly
- EM Interference



1	For Comment	28.01.15
Rev	Amendment	Date

Mantra

Mantra Services Limited
 Covert Farm Barn, Long Lane, East Haddon NN6 8DU
 Tel: 01604 770955
 mail@mantraservices.co.uk

Client
Meadow Partners

Project Title
Pentavia Mill Hill

Drawing Title
**Pentavia Mill Hill
 Utility Survey Sheet 5**

Drawn By **RB** Checked By **KF** Approved By **AB**

Date **28.01.15** Scale **1:100 @ A1**

Purpose
Survey

Drawing Number **716_005** Rev **1**



- Notes**
- This drawing is to be read in conjunction with all relevant specifications, service providers record drawings, RICS Surveys of Land, Buildings and Utility Surveys at Scales of 1:500 and Larger and the surveyors report
 - This is a composite of two surveys. Where information is from a third party it is unknown which services are taken from records. This should be considered when excavating
 - Do not scale from this drawing
 - A single line indicating a service location does not indicate the number of utilities in a location
 - Electromagnetic and Ground Penetrating Radar methods are employed to complete information on buried services. All data can be effected by external conditions such as ground conditions, interference, soil types, moisture content and ground return currents. All depths should be viewed as indicative and all persons carrying out excavations should satisfy themselves of all service locations prior to commencing works. EM interference occurs within 0.5m of buildings and fences, thus services within this zone may be unable to be traced. GPR is also affected in the proximity of buildings and fences.
 - Any excavations should be carried out in accordance with HSG47 by trained personnel

Availability of service records

Type	Comments	Type	Comments
Drainage	Refer to survey report appendix C	Gas	Refer to survey report appendix C
Electric	Refer to survey report appendix C	Cable	Refer to survey report appendix C
BT	Refer to survey report appendix C	Pipeline	Refer to survey report appendix C
Water	Refer to survey report appendix C	Other	Refer to survey report appendix C

- | | |
|-------------------------------|----------------------------|
| (A) - Assumed Line | LP - Lamp Column |
| BH - Borehole | MH - Manhole |
| BO - Bollard | MW - Microwave |
| CBL - Concrete Block | OH - Overhead Cable |
| CL - Cable Level | PBC - Push Button Control |
| CTV - Cable TV Point | PID - Intruder Detection |
| D 0.5 - Utility Depth | PO - Post |
| D/U - Depth Unknown | (R) - Utility From Records |
| DIA - Pipe Diameter | RE - Rodding Eye |
| EMP - Electricity Marker Post | RWP - Rodding Pipe |
| EOT - End of trace | SP - Sign Post |
| (loss of reading) | SV - Stop Valve |
| EP - Electricity Pole | TH - Trial Hole |
| FH - Fire Hydrant | TS - Traffic Signal |
| GMP - Gas Marker Post | UTS - Unable to Survey |
| GV - Gas Valve | UTT - Unable to Trace |
| GY - Gully | UTL - Unable to Lift |
| IB - Illuminated Bollard | VP - Soil & Vent Pipe |
| IC - Inspection Chamber | WMP - Water Marker Post |
| IL - Invert Level | |

- | | |
|-------------------------|--|
| Storm Drainage - SW | GPR Ineffective |
| Foul Drainage - FW | Fence |
| Electricity - E | Important Notes, Refer To Surveyors Report Section 3 |
| Water - W | Metadata, Refer To Surveyors Report Appendix A |
| Gas - G | |
| Unknown EM - EM | Extent of Chamber Walls |
| Unknown GPR - GPR | |
| Comms - T | GPR Anomaly |
| Empty Duct - DU | EM Interference |
| Earth Cable - EA | |
| Utility Survey Boundary | |



Rev	Amendment	Date
1	For Comment	28.01.15

Mantra

Mantra Services Limited
Covert Farm Barn, Long Lane, East Haddon NN6 8DU
Tel: 01604 770955
mail@mantraservices.co.uk

Client
Meadow Partners

Project Title
Pentavia Mill Hill


Drawing Title
**Pentavia Mill Hill
Utility Survey Sheet 6**

Drawn By RB	Checked By KF	Approved By AB
-----------------------	-------------------------	--------------------------

Date **28.01.15** Scale **1:100 @ A1**

Purpose
Survey

Drawing Number 716_006	Rev 1
----------------------------------	-----------------

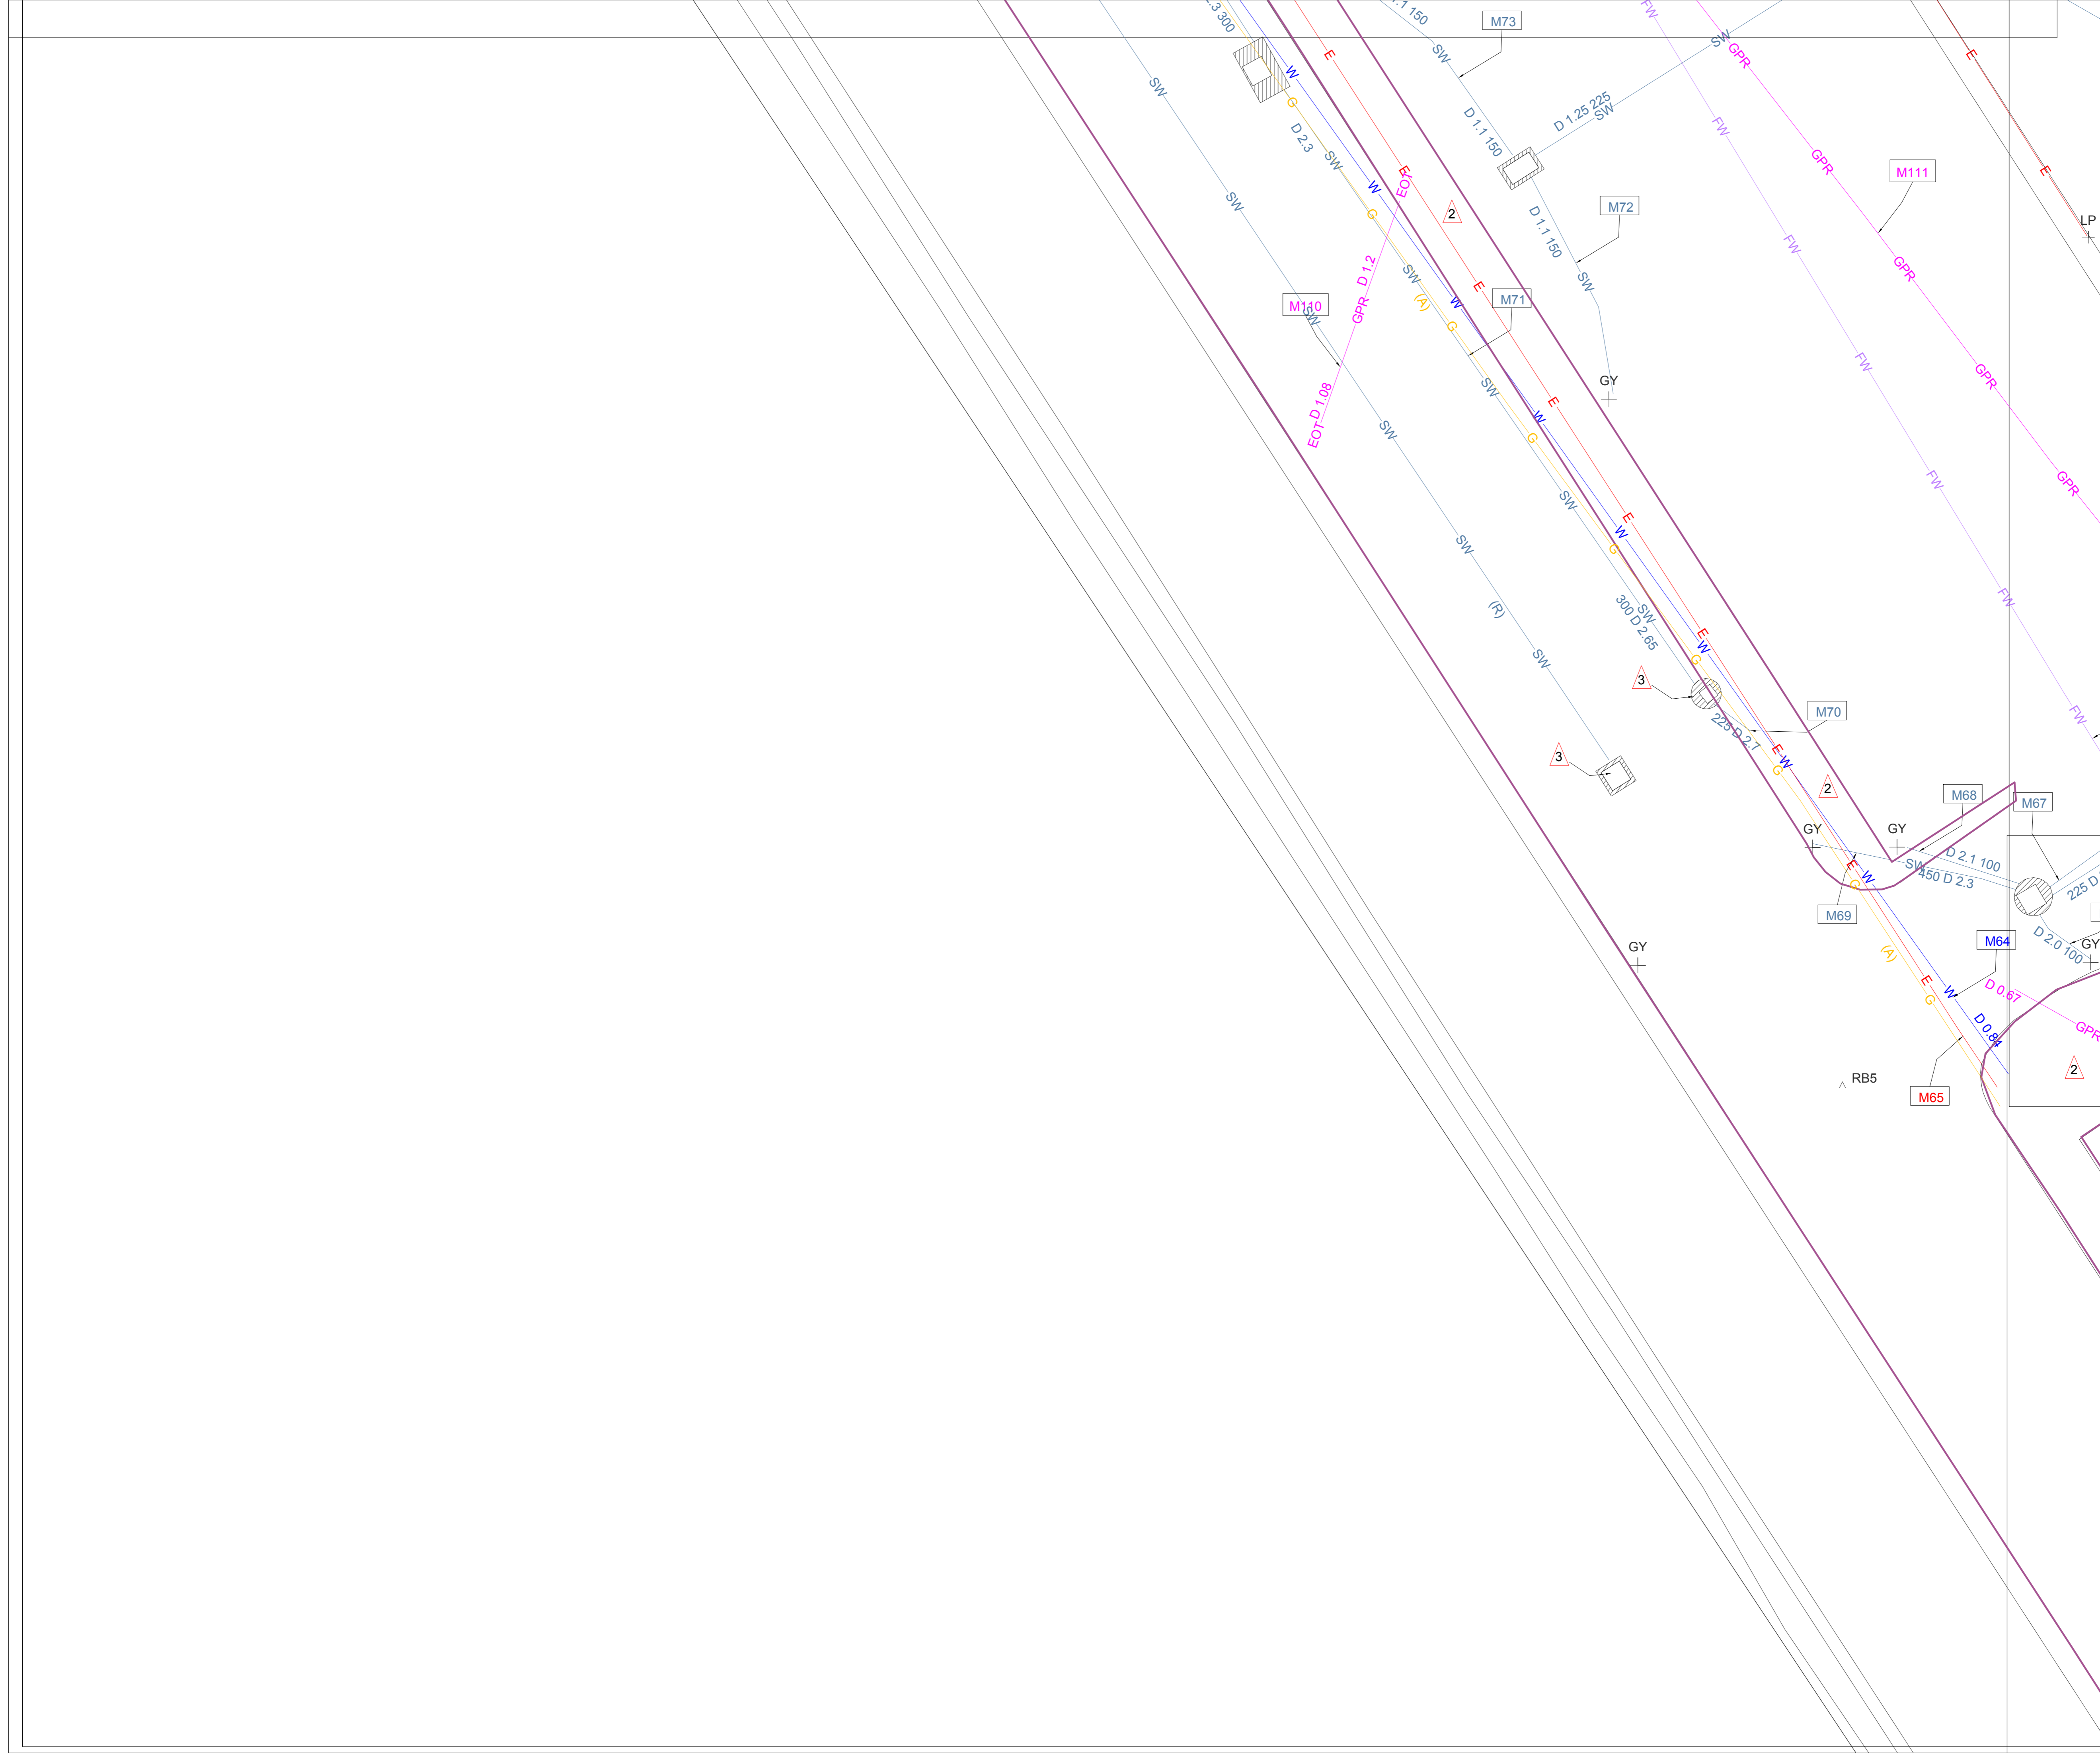

- Notes**
1. This drawing is to be read in conjunction with all relevant specifications, service providers record drawings, RICS Surveys of Land, Buildings and Utility Surveys at Scales of 1:500 and Larger and the surveyors report
 2. This is a composite of two surveys. Where information is from a third party it is unknown which services are taken from records. This should be considered when excavating
 3. Do not scale from this drawing
 4. A single line indicating a service location does not indicate the number of utilities in a location
 5. Electromagnetic and Ground Penetrating Radar methods are employed to complete information on buried services. All data can be effected by external conditions such as ground conditions, interference, soil types, moisture content and ground return currents. All depths should be viewed as indicative and all persons carrying out excavations should satisfy themselves of all service locations prior to commencing works. EM interference occurs within 0.5m of buildings and fences, thus services within this zone may be unable to be traced. GPR is also affected in the proximity of buildings and fences.
 6. Any excavations should be carried out in accordance with HSG47 by trained personnel

Availability of service records

Type	Comments	Type	Comments
Drainage	Refer to survey report appendix C	Gas	Refer to survey report appendix C
Electric	Refer to survey report appendix C	Cable	Refer to survey report appendix C
BT	Refer to survey report appendix C	Pipeline	Refer to survey report appendix C
Water	Refer to survey report appendix C	Other	Refer to survey report appendix C

- | | |
|-------------------------------|----------------------------|
| (A) - Assumed Line | LP - Lamp Column |
| BH - Borehole | MH - Manhole |
| BO - Bollard | MW - Microwave |
| CBL - Concrete Block | OH - Overhead Cable |
| CL - Cable Level | PBC - Push Button Control |
| CTV - Cable TV Point | PID - Intruder Detection |
| D 0.5 - Utility Depth | PO - Post |
| D/U - Depth Unknown | (R) - Utility From Records |
| DIA - Pipe Diameter | RE - Rodding Eye |
| EMP - Electricity Marker Post | RWP - Down Pipe |
| EOT - End of trace | SP - Sign Post |
| (loss of reading) | SV - Stop Valve |
| EP - Electricity Pole | TH - Trial Hole |
| FH - Fire Hydrant | TS - Traffic Signal |
| GMP - Gas Marker Post | UTS - Unable to Survey |
| GV - Gas Valve | UTT - Unable to Trace |
| GY - Gully | UTL - Unable to Lift |
| IB - Illuminated Bollard | VP - Soil & Vent Pipe |
| IC - Inspection Chamber | WMP - Water Marker Post |
| IL - Invert Level | |

- | | |
|-------------------------|--|
| Storm Drainage - SW | GPR Ineffective |
| Foul Drainage - FW | Fence |
| Electricity - E | Important Notes, Refer To Surveyors Report Section 3 |
| Water - W | Metadata, Refer To Surveyors Report Appendix A |
| Gas - G | Extent of Chamber Walls |
| Unknown EM - EM | GPR Anomaly |
| Unknown GPR - GPR | EM Interference |
| Comms - T | |
| Empty Duct - DU | |
| Earth Cable - EA | |
| Utility Survey Boundary | |



1	For Comment	28.01.15
Rev	Amendment	Date

Mantra

Mantra Services Limited
Covert Farm Barn, Long Lane, East Haddon NN6 8DU
Tel: 01604 770955
mail@mantraservices.co.uk

Client
Meadow Partners

Project Title
Pentavia Mill Hill


Drawing Title
**Pentavia Mill Hill
Utility Survey Sheet 7**

Drawn By RB	Checked By KF	Approved By AB
-----------------------	-------------------------	--------------------------

Date **28.01.15** Scale **1:100 @ A1**

Purpose
Survey

Drawing Number **716_007** Rev **1**

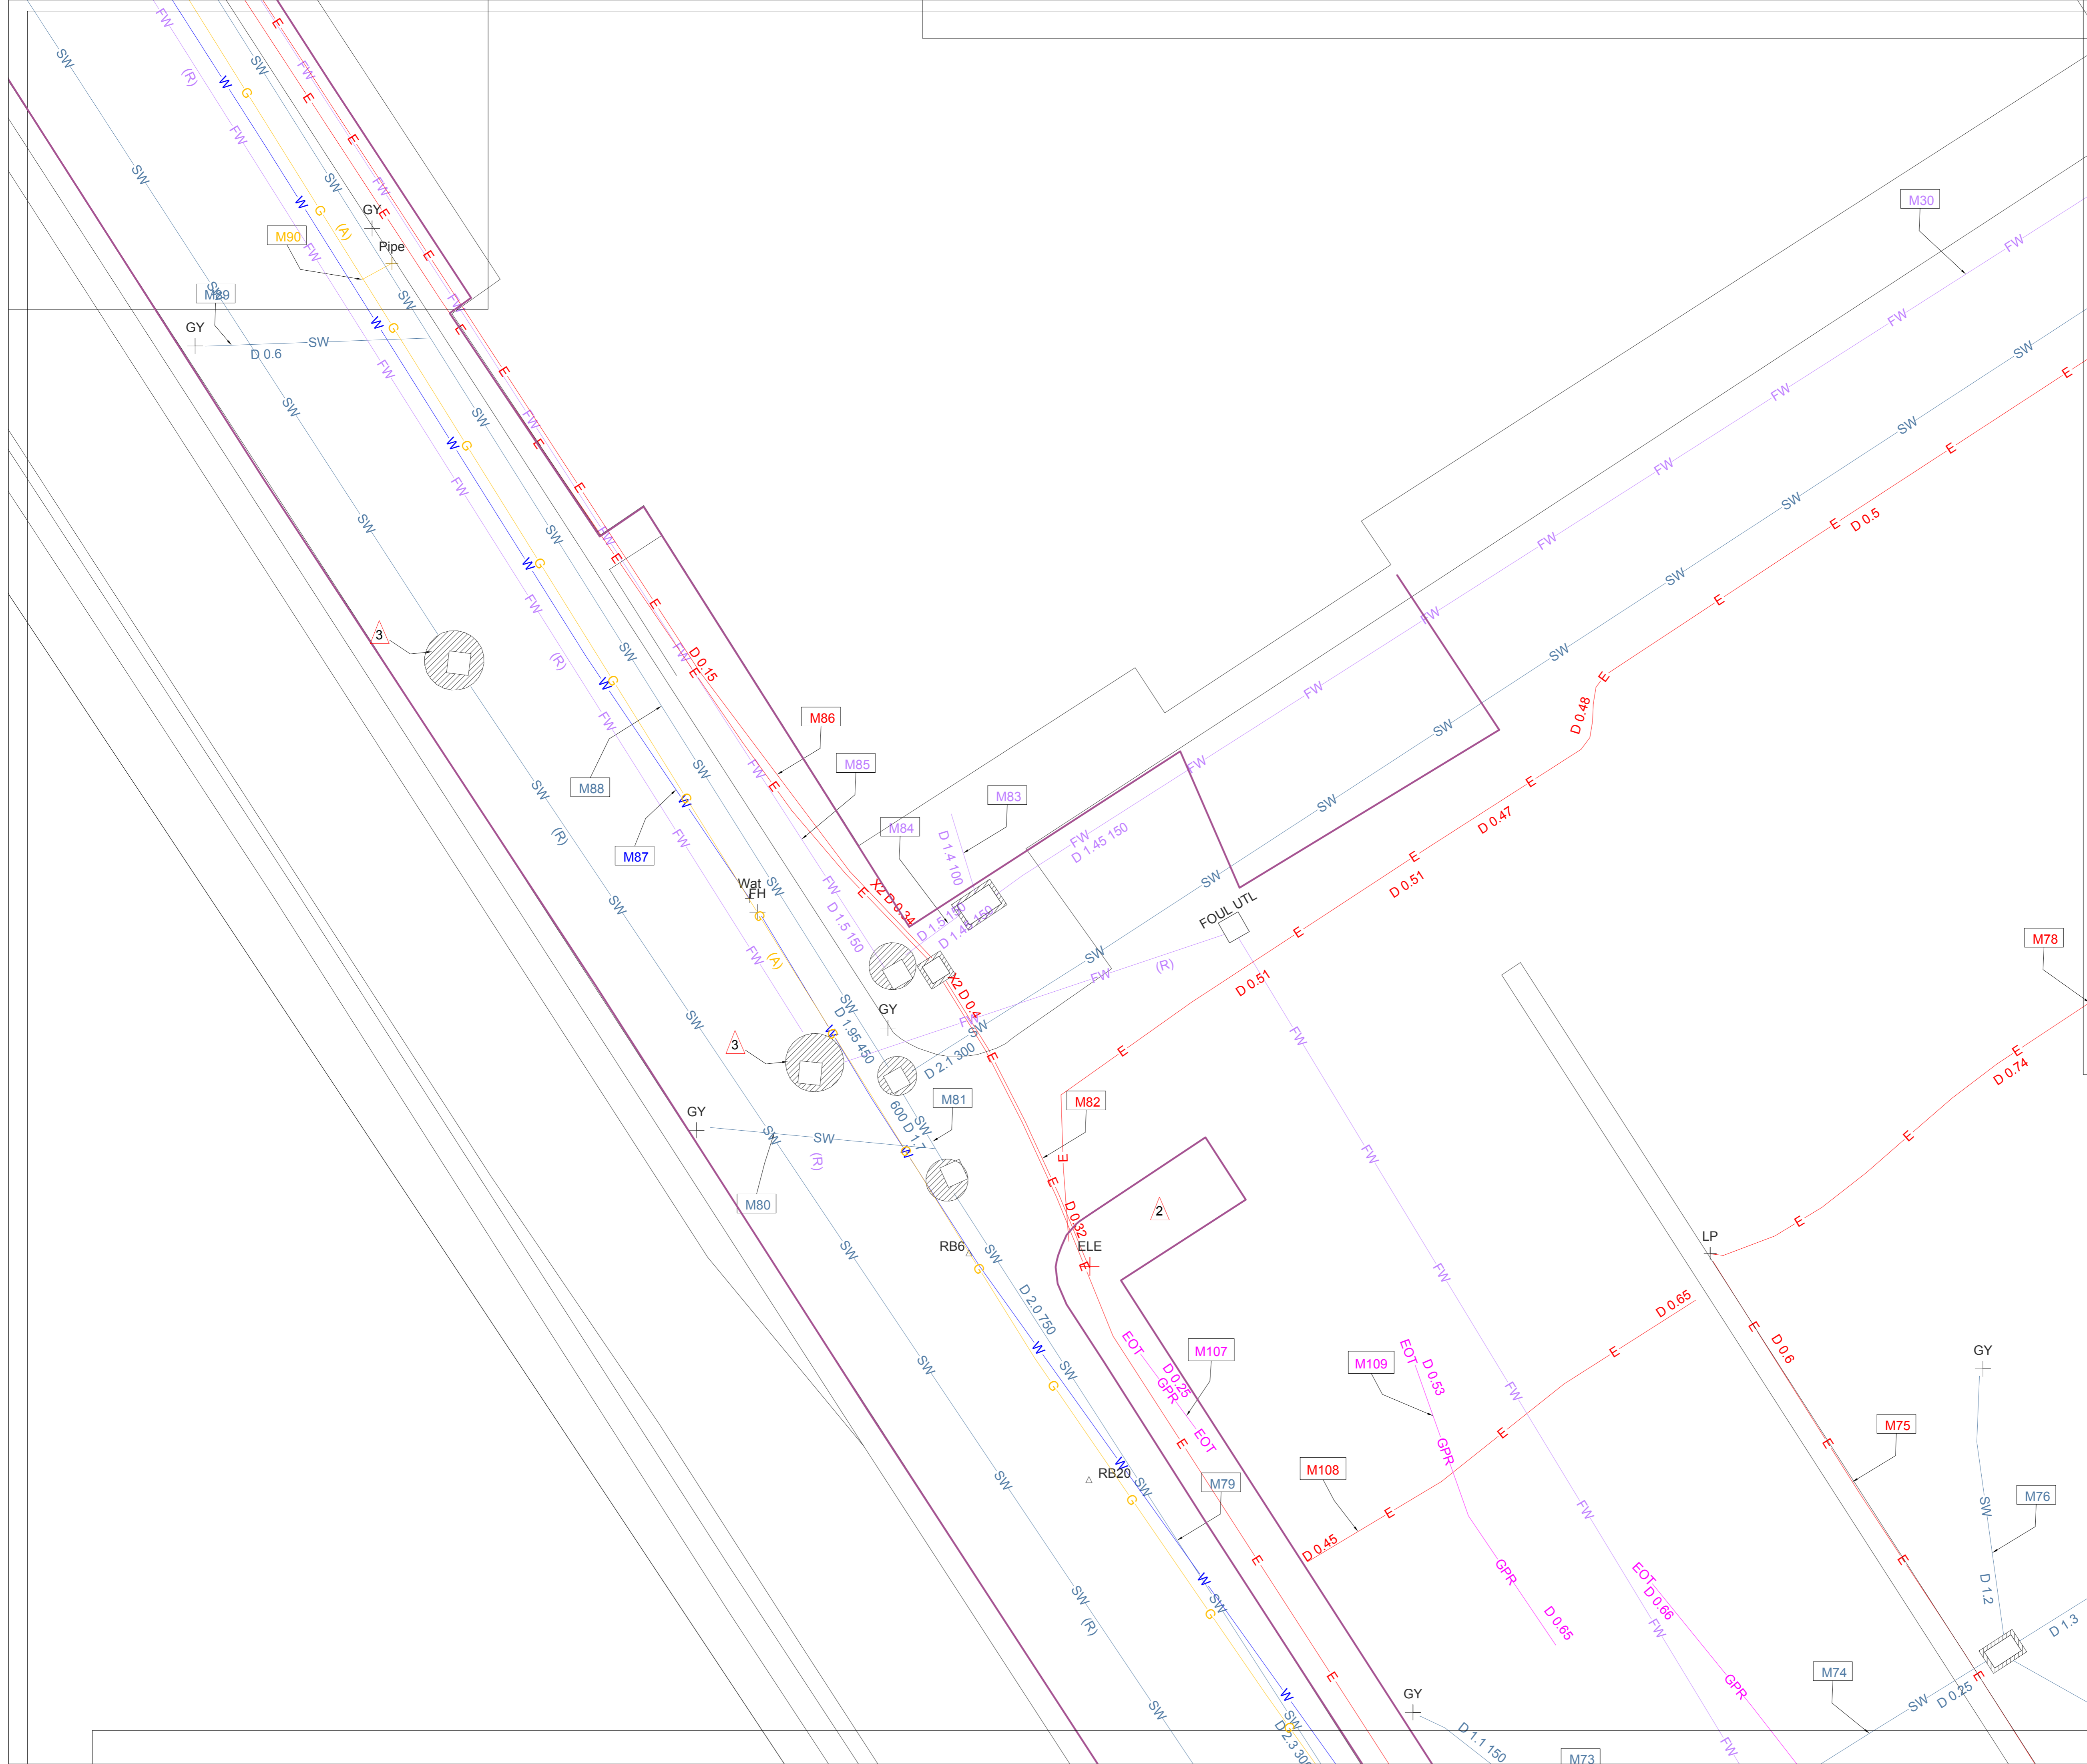


- Notes**
1. This drawing is to be read in conjunction with all relevant specifications, service providers record drawings, RICS Surveys of Land, Buildings and Utility Surveys at Scales of 1:500 and Larger and the surveyors report
 2. This is a composite of two surveys. Where information is from a third party it is unknown which services are taken from records. This should be considered when excavating
 3. Do not scale from this drawing
 4. A single line indicating a service location does not indicate the number of utilities in a location
 5. Electromagnetic and Ground Penetrating Radar methods are employed to complete information on buried services. All data can be effected by external conditions such as ground conditions, interference, soil types, moisture content and ground return currents. All depths should be viewed as indicative and all persons carrying out excavations should satisfy themselves of all service locations prior to commencing works. EM interference occurs within 0.5m of buildings and fences, thus services within this zone may be unable to be traced. GPR is also affected in the proximity of buildings and fences.
 6. Any excavations should be carried out in accordance with HSG47 by trained personnel

Availability of service records

Type	Comments	Type	Comments
Drainage	Refer to survey report appendix C	Gas	Refer to survey report appendix C
Electric	Refer to survey report appendix C	Cable	Refer to survey report appendix C
BT	Refer to survey report appendix C	Pipeline	Refer to survey report appendix C
Water	Refer to survey report appendix C	Other	Refer to survey report appendix C

- (A) - Assumed Line**
 BH - Borehole
 BO - Bollard
 CBL - Concrete Block
 CL - Cable Level
 CTV - Cable TV Point
 D 0.5 - Utility Depth
 DIA - Pipe Diameter
 EMP - Electricity Marker Post
 EOT - End of trace (loss of reading)
 EP - Electricity Pole
 FH - Fire Hydrant
 GMP - Gas Marker Post
 GV - Gas Valve
 GY - Gully
 IB - Illuminated Bollard
 IC - Inspection Chamber
 IL - Invert Level
- LP - Lamp Column**
 MH - Manhole
 MW - Microwave
 OH - Overhead Cable
 PBC - Push Button Control
 PID - Intruder Detection
 PO - Post
 (R) - Utility From Records
 RE - Rodding Eye
 RWP - Rod Down Pipe
 SP - Sign Post
 SV - Stop Valve
 TH - Trial Hole
 TS - Traffic Signal
 UTS - Unable to Survey
 UTT - Unable to Trace
 UTL - Unable to Lift
 VP - Soil & Vent Pipe
 WMP - Water Marker Post

- Storm Drainage - SW
 Foul Drainage - FW
 Electricity - E
 Water - W
 Gas - G
 Unknown EM - EM
 Unknown GPR - GPR
 Comms - C
 Empty Duct - DU
 Earth Cable - EA
 Utility Survey Boundary
- GPR Ineffective
 Fence
 Important Notes, Refer To Surveyors Report Section 3
 Metadata, Refer To Surveyors Report Appendix A
 Extent of Chamber Walls
 GPR Anomaly
 EM Interference

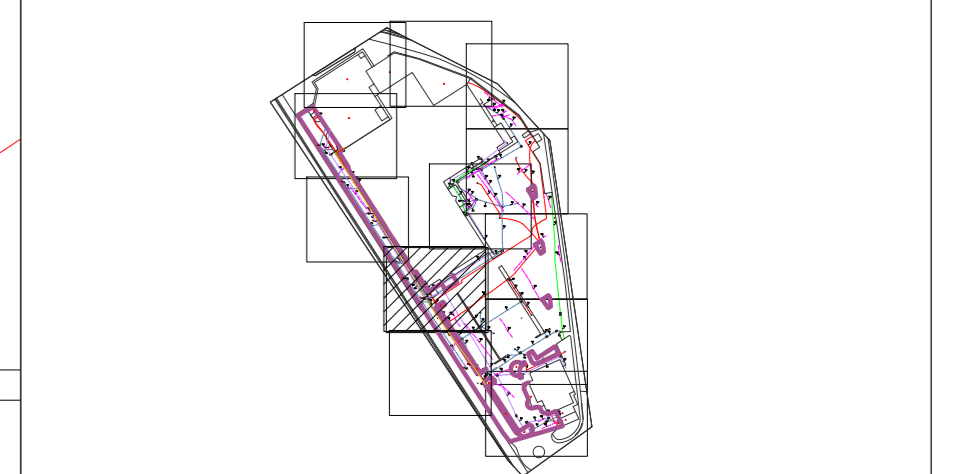


Rev	For Comment	Date
1	For Comment	28.01.15
Rev	Amendment	Date

Mantra

Mantra Services Limited
 Covert Farm Barn, Long Lane, East Haddon NN6 8DU
 Tel: 01604 770955
 mail@mantraservices.co.uk

Client	Meadow Partners				
Project Title	Pentavia Mill Hill				
Drawing Title	Pentavia Mill Hill Utility Survey Sheet 8				
Drawn By	RB	Checked By	KF	Approved By	AB
Date	28.01.15	Scale	1:100 @ A1		
Purpose	Survey				
Drawing Number	716_008	Rev	1		

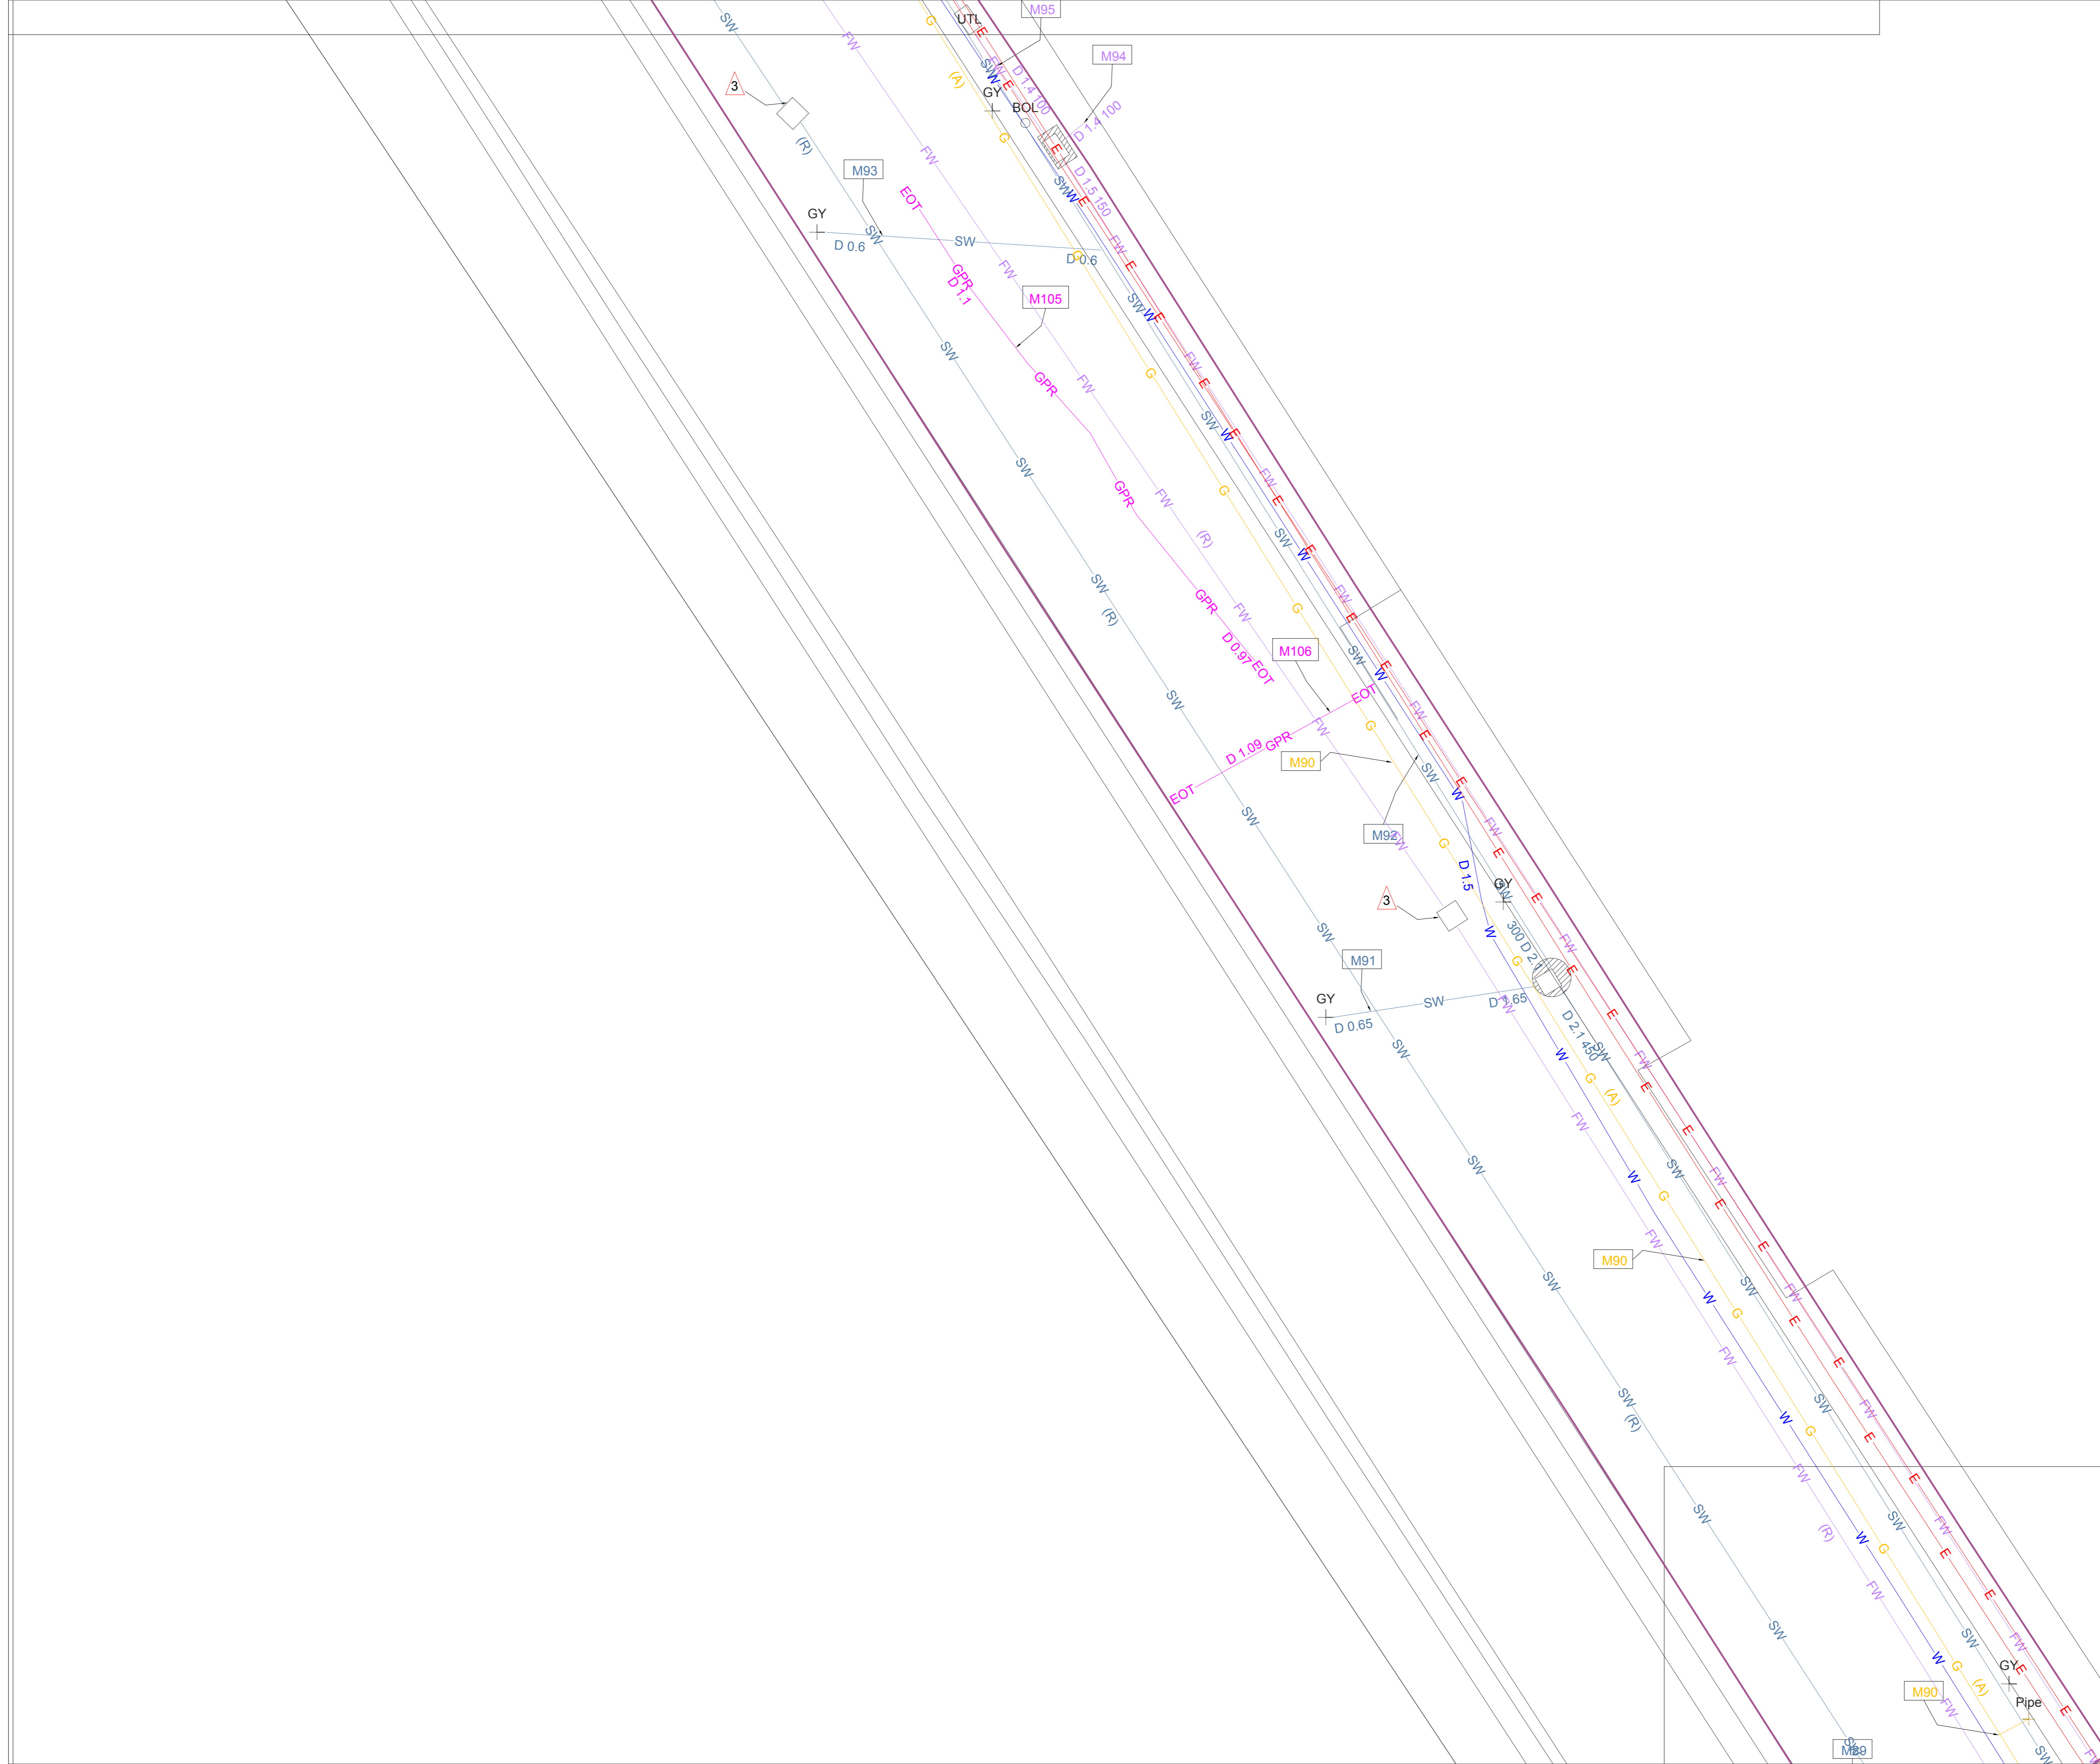

- Notes**
- This drawing is to be read in conjunction with all relevant specifications, service providers record drawings, RICS Surveys of Land, Buildings and Utility Surveys at Scales of 1:500 and Larger and the surveyors report
 - This is a composite of two surveys. Where information is from a third party it is unknown which services are taken from records. This should be considered when excavating
 - Do not scale from this drawing
 - A single line indicating a service location does not indicate the number of utilities in a location
 - Electromagnetic and Ground Penetrating Radar methods are employed to complete information on buried services. All data can be effected by external conditions such as ground conditions, interference, soil types, moisture content and ground return currents. All depths should be viewed as indicative and all persons carrying out excavations should satisfy themselves of all service locations prior to commencing works. EM interference occurs within 0.5m of buildings and fences, thus services within this zone may be unable to be traced. GPR is also affected in the proximity of buildings and fences.
 - Any excavations should be carried out in accordance with HSG47 by trained personnel

Availability of service records

Type	Comments	Type	Comments
Drainage	Refer to survey report appendix C	Gas	Refer to survey report appendix C
Electric	Refer to survey report appendix C	Cable	Refer to survey report appendix C
BT	Refer to survey report appendix C	Pipeline	Refer to survey report appendix C
Water	Refer to survey report appendix C	Other	Refer to survey report appendix C

- | | |
|-------------------------------|----------------------------|
| (A) - Assumed Line | LP - Lamp Column |
| BH - Borehole | MH - Manhole |
| BO - Bollard | MW - Microwave |
| CBL - Concrete Block | OH - Overhead Cable |
| CL - Cable Level | PBC - Push Button Control |
| CTV - Cable TV Point | PID - Intruder Detection |
| D 0.5 - Utility Depth | PO - Post |
| D/U - Depth Unknown | (R) - Utility From Records |
| DIA - Pipe Diameter | RE - Rodding Eye |
| EMP - Electricity Marker Post | RWP - Down Pipe |
| EOT - End of trace | SP - Sign Post |
| (loss of reading) | SV - Stop Valve |
| EP - Electricity Pole | TH - Trial Hole |
| FH - Fire Hydrant | TS - Traffic Signal |
| GMP - Gas Marker Post | UTS - Unable to Survey |
| GV - Gas Valve | UTT - Unable to Trace |
| GY - Gully | UTL - Unable to Lift |
| IB - Illuminated Bollard | VP - Soil & Vent Pipe |
| IC - Inspection Chamber | WMP - Water Marker Post |
| IL - Invert Level | |

- | | |
|-------------------------|--|
| Storm Drainage - SW | GPR Ineffective |
| Foul Drainage - FW | Fence |
| Electricity - E | Important Notes, Refer To Surveyors Report Section 3 |
| Water - W | Metadata, Refer To Surveyors Report Appendix A |
| Gas - G | |
| Unknown EM - EM | Extent of Chamber Walls |
| Unknown GPR - GPR | |
| Comms - T | GPR Anomaly |
| Empty Duct - DU | EM Interference |
| Earth Cable - EA | |
| Utility Survey Boundary | |



Rev	Amendment	Date
1	For Comment	28.01.15

Mantra

Mantra Services Limited
 Covert Farm Barn, Long Lane, East Haddon NN6 8DU
 Tel: 01604 770955
 mail@mantraservices.co.uk

Client
Meadow Partners

Project Title
Pentavia Mill Hill

Drawing Title
**Pentavia Mill Hill
 Utility Survey Sheet 9**

Drawn By RB	Checked By KF	Approved By AB
-----------------------	-------------------------	--------------------------

Date **28.01.15** Scale **1:100 @ A1**

Purpose
Survey

Drawing Number 716_009	Rev 1
----------------------------------	-----------------

- Notes**
1. This drawing is to be read in conjunction with all relevant specifications, service providers record drawings, RICS Surveys of Land, Buildings and Utility Surveys at Scales of 1:500 and Larger and the surveyors report
 2. This is a composite of two surveys. Where information is from a third party it is unknown which services are taken from records. This should be considered when excavating
 3. Do not scale from this drawing
 4. A single line indicating a service location does not indicate the number of utilities in a location
 5. Electromagnetic and Ground Penetrating Radar methods are employed to complete information on buried services. All data can be effected by external conditions such as ground conditions, interference, soil types, moisture content and ground return currents. All depths should be viewed as indicative and all persons carrying out excavations should satisfy themselves of all service locations prior to commencing works. EM interference occurs within 0.5m of buildings and fences, thus services within this zone may be unable to be traced. GPR is also affected in the proximity of buildings and fences.
 6. Any excavations should be carried out in accordance with HSG47 by trained personnel

Availability of service records

Type	Comments	Type	Comments
Drainage	Refer to survey report appendix C	Gas	Refer to survey report appendix C
Electric	Refer to survey report appendix C	Cable	Refer to survey report appendix C
BT	Refer to survey report appendix C	Pipeline	Refer to survey report appendix C
Water	Refer to survey report appendix C	Other	Refer to survey report appendix C

- | | |
|-------------------------------|----------------------------|
| (A) - Assumed Line | LP - Lamp Column |
| BH - Borehole | MH - Manhole |
| BO - Bollard | MW - Microwave |
| CBL - Concrete Block | OH - Overhead Cable |
| CL - Cable Level | PBC - Push Button Control |
| CTV - Cable TV Point | PID - Intruder Detection |
| D 0.5 - Utility Depth | PO - Post |
| D/U - Depth Unknown | (R) - Utility From Records |
| DIA - Pipe Diameter | RE - Rodding Eye |
| EMP - Electricity Marker Post | RWP - Rodding Pipe |
| EOT - End of trace | SP - Sign Post |
| (loss of reading) | SV - Stop Valve |
| EP - Electricity Pole | TH - Trial Hole |
| FH - Fire Hydrant | TS - Traffic Signal |
| GMP - Gas Marker Post | UTS - Unable to Survey |
| GV - Gas Valve | UTT - Unable to Trace |
| GY - Gully | UTL - Unable to Lift |
| IB - Illuminated Bollard | VP - Soil & Vent Pipe |
| IC - Inspection Chamber | WMP - Water Marker Post |
| IL - Invert Level | |

- | | |
|-------------------------|--|
| Storm Drainage - SW | GPR Ineffective |
| Foul Drainage - FW | Fence |
| Electricity - E | Important Notes, Refer To Surveyors Report Section 3 |
| Water - W | Metadata, Refer To Surveyors Report Appendix A |
| Gas - G | Extent of Chamber Walls |
| Unknown EM - EM | GPR Anomaly |
| Unknown GPR - GPR | EM Interference |
| Comms - T | |
| Empty Duct - DU | |
| Earth Cable - EA | |
| Utility Survey Boundary | |



Rev	Amendment	Date
1	For Comment	28.01.15



Mantra Services Limited
Covert Farm Barn, Long Lane, East Haddon NN6 8DU
Tel: 01604 770955
mail@mantraservices.co.uk

Client
Meadow Partners

Project Title
Pentavia Mill Hill


Drawing Title
**Pentavia Mill Hill
Utility Survey Sheet 10**

Drawn By RB	Checked By KF	Approved By AB
-----------------------	-------------------------	--------------------------

Date **28.01.15** Scale **1:100 @ A1**

Purpose
Survey

Drawing Number 716_010	Rev 1
----------------------------------	-----------------

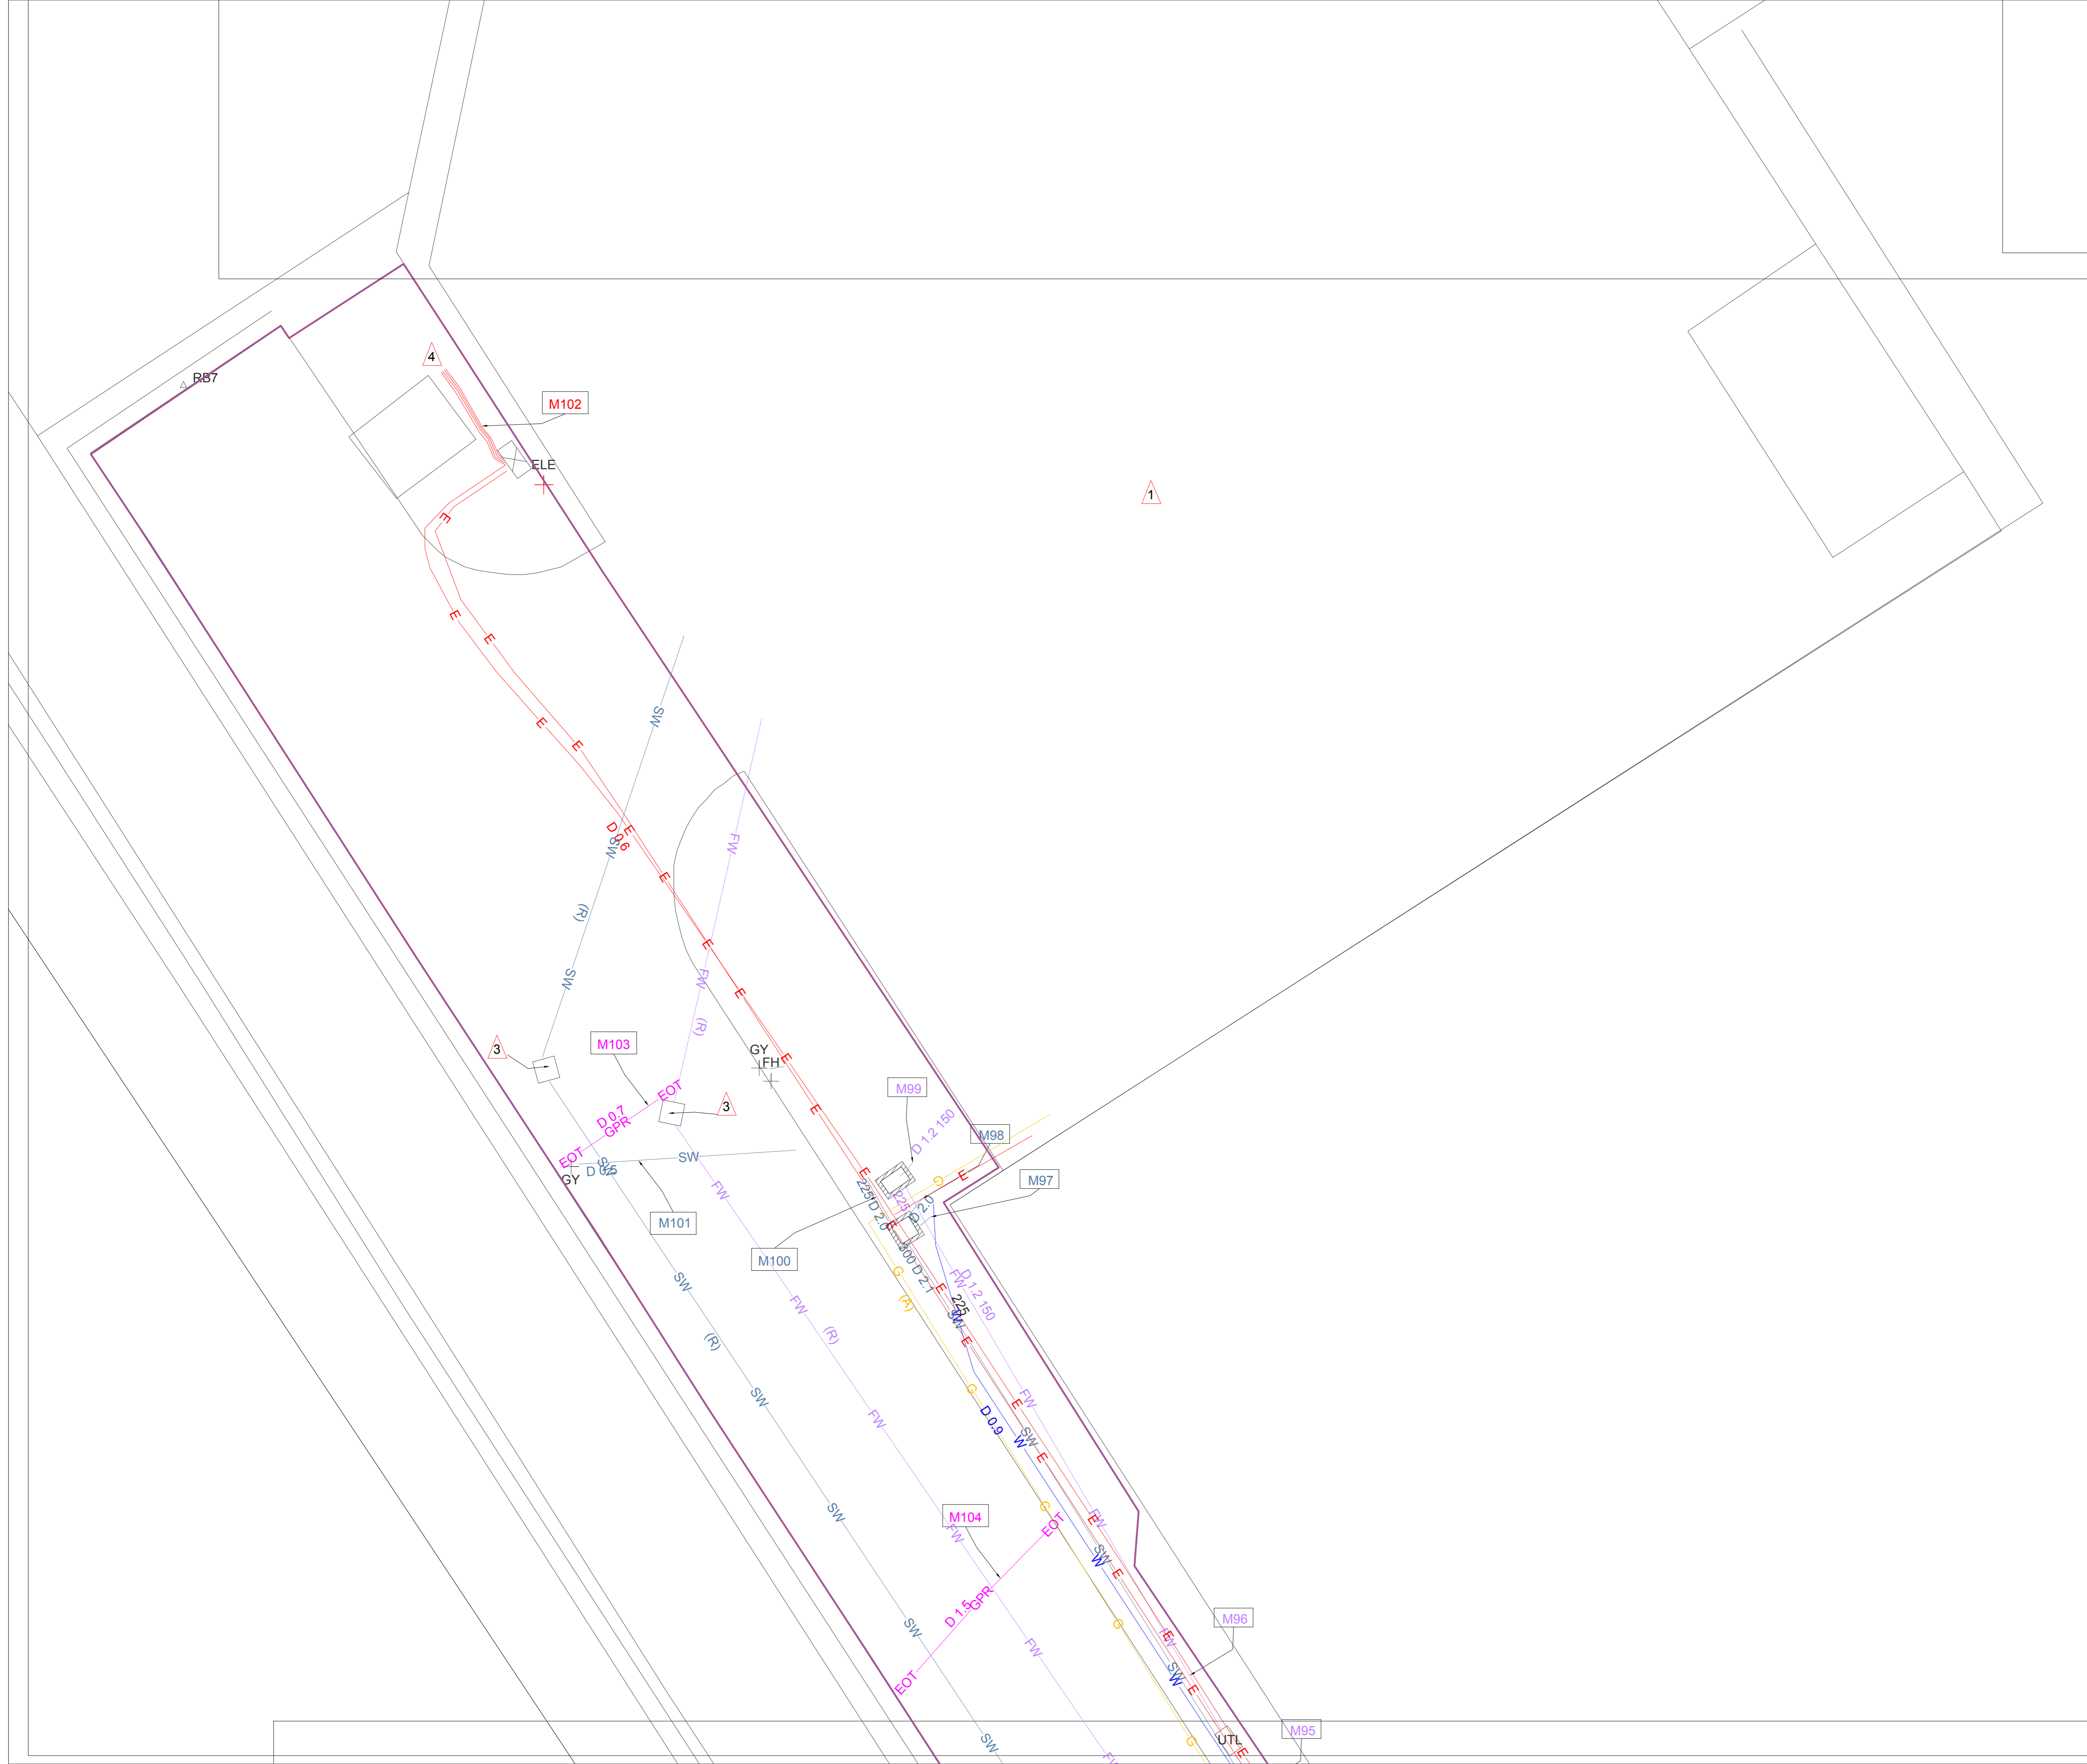

Notes

1. This drawing is to be read in conjunction with all relevant specifications, service providers record drawings, RICS Surveys of Land, Buildings and Utility Surveys at Scales of 1:500 and Larger and the surveyors report
2. This is a composite of two surveys. Where information is from a third party it is unknown which services are taken from records. This should be considered when excavating
3. Do not scale from this drawing
4. A single line indicating a service location does not indicate the number of utilities in a location
5. Electromagnetic and Ground Penetrating Radar methods are employed to complete information on buried services. All data can be effected by external conditions such as ground conditions, interference, soil types, moisture content and ground return currents. All depths should be viewed as indicative and all persons carrying out excavations should satisfy themselves of all service locations prior to commencing works. EM interference occurs within 0.5m of buildings and fences, thus services within this zone may be unable to be traced. GPR is also affected in the proximity of buildings and fences.
6. Any excavations should be carried out in accordance with HSG47 by trained personnel

Availability of service records			
Type	Comments	Type	Comments
Drainage	Refer to survey report appendix C	Gas	Refer to survey report appendix C
Electric	Refer to survey report appendix C	Cable	Refer to survey report appendix C
BT	Refer to survey report appendix C	Pipeline	Refer to survey report appendix C
Water	Refer to survey report appendix C	Other	Refer to survey report appendix C

- | | |
|-------------------------------|----------------------------|
| (A) - Assumed Line | LP - Lamp Column |
| BH - Borehole | MH - Manhole |
| BO - Bollard | MW - Microwave |
| CBL - Concrete Block | OH - Overhead Cable |
| CL - Cable Level | PBC - Push Button Control |
| CTV - Cable TV Point | PID - Intruder Detection |
| D 0.5 - Utility Depth | PO - Post |
| D/U - Depth Unknown | (R) - Utility From Records |
| DIA - Pipe Diameter | RE - Rodding Eye |
| EMP - Electricity Marker Post | RWP - Down Pipe |
| EOT - End of trace | SP - Sign Post |
| (loss of reading) | SV - Stop Valve |
| EP - Electricity Pole | TH - Trial Hole |
| FH - Fire Hydrant | TS - Traffic Signal |
| GMP - Gas Marker Post | UTS - Unable to Survey |
| GV - Gas Valve | UTT - Unable to Trace |
| GY - Gully | UTL - Unable to Lift |
| IB - Illuminated Bollard | VP - Soil & Vent Pipe |
| IC - Inspection Chamber | WMP - Water Marker Post |
| IL - Invert Level | |

Storm Drainage - SW	GPR Ineffective
Foul Drainage - FW	Fence
Electricity - E	Important Notes, Refer To Surveyors Report Section 3
Water - W	Metadata, Refer To Surveyors Report Appendix A
Gas - G	Extent of Chamber Walls
Unknown EM - EM	GPR Anomaly
Unknown GPR - GPR	EM Interference
Comms - T	
Empty Duct - DU	
Earth Cable - EA	
Utility Survey Boundary	



Rev	Amendment	Date
1	For Comment	28.01.15



Mantra Services Limited
 Covert Farm Barn, Long Lane, East Haddon NN6 8DU
 Tel: 01604 770955
 mail@mantraservices.co.uk

Client
Meadow Partners

Project Title
Pentavia Mill Hill

Drawing Title
**Pentavia Mill Hill
 Utility Survey Sheet 11**

Drawn By RB	Checked By KF	Approved By AB
-----------------------	-------------------------	--------------------------

Date **28.01.15** Scale **1:100 @ A1**

Purpose
Survey

Drawing Number 716_011	Rev 1
----------------------------------	-----------------

- Notes**
1. This drawing is to be read in conjunction with all relevant specifications, service providers record drawings, RICS Surveys of Land, Buildings and Utility Surveys at Scales of 1:500 and Larger and the surveyors report
 2. This is a composite of two surveys. Where information is from a third party it is unknown which services are taken from records. This should be considered when excavating
 3. Do not scale from this drawing
 4. A single line indicating a service location does not indicate the number of utilities in a location
 5. Electromagnetic and Ground Penetrating Radar methods are employed to compile information on buried services. All data can be effected by external conditions such as ground conditions, interference, soil types, moisture content and ground return currents. All depths should be viewed as indicative and all persons carrying out excavations should satisfy themselves of all service locations prior to commencing works. EM interference occurs within 0.5m of buildings and fences, thus services within this zone may be unable to be traced. GPR is also affected in the proximity of buildings and fences.
 6. Any excavations should be carried out in accordance with HSG47 by trained personnel

Availability of service records

Type	Comments	Type	Comments
Drainage	Refer to survey report appendix C	Gas	Refer to survey report appendix C
Electric	Refer to survey report appendix C	Cable	Refer to survey report appendix C
BT	Refer to survey report appendix C	Pipeline	Refer to survey report appendix C
Water	Refer to survey report appendix C	Other	Refer to survey report appendix C

- | | |
|-------------------------------|----------------------------|
| (A) - Assumed Line | LP - Lamp Column |
| BH - Borehole | MH - Manhole |
| BO - Bollard | MW - Microwave |
| CBL - Concrete Block | OH - Overhead Cable |
| CL - Cable Level | PBC - Push Button Control |
| CTV - Cable TV Point | PID - Intruder Detection |
| D 0.5 - Utility Depth | PO - Post |
| D/U - Depth Unknown | (R) - Utility From Records |
| DIA - Pipe Diameter | RE - Rodding Eye |
| EMP - Electricity Marker Post | RWP - Down Pipe |
| EOT - End of trace | SP - Sign Post |
| (loss of reading) | SV - Stop Valve |
| EP - Electricity Pole | TH - Trial Hole |
| FH - Fire Hydrant | TS - Traffic Signal |
| GMP - Gas Marker Post | UTS - Unable to Survey |
| GV - Gas Valve | UTT - Unable to Trace |
| GY - Gully | UTL - Unable to Lift |
| IB - Illuminated Bollard | VP - Soil & Vent Pipe |
| IC - Inspection Chamber | WMP - Water Marker Post |
| IL - Invert Level | |

- | | |
|-------------------------|--|
| Storm Drainage - SW | GPR Ineffective |
| Foul Drainage - FW | Fence |
| Electricity - E | Important Notes, Refer To Surveyors Report Section 3 |
| Water - W | Metadata, Refer To Surveyors Report Appendix A |
| Gas - G | Extent of Chamber Walls |
| Unknown EM - EM | GPR Anomaly |
| Unknown GPR - GPR | EM Interference |
| Comms - T | |
| Empty Duct - DU | |
| Earth Cable - EA | |
| Utility Survey Boundary | |



Rev	Amendment	Date
1	For Comment	28.01.15



Mantra Services Limited
 Covert Farm Barn, Long Lane, East Haddon NN6 8DU
 Tel: 01604 770955
 mail@mantraservices.co.uk

Client
Meadow Partners

Project Title
Pentavia Mill Hill


Drawing Title
**Pentavia Mill Hill
 Utility Survey Sheet 12**

Drawn By RB	Checked By KF	Approved By AB
-----------------------	-------------------------	--------------------------

Date **28.01.15** Scale **1:100 @ A1**

Purpose
Survey

Drawing Number 716_012	Rev 1
----------------------------------	-----------------

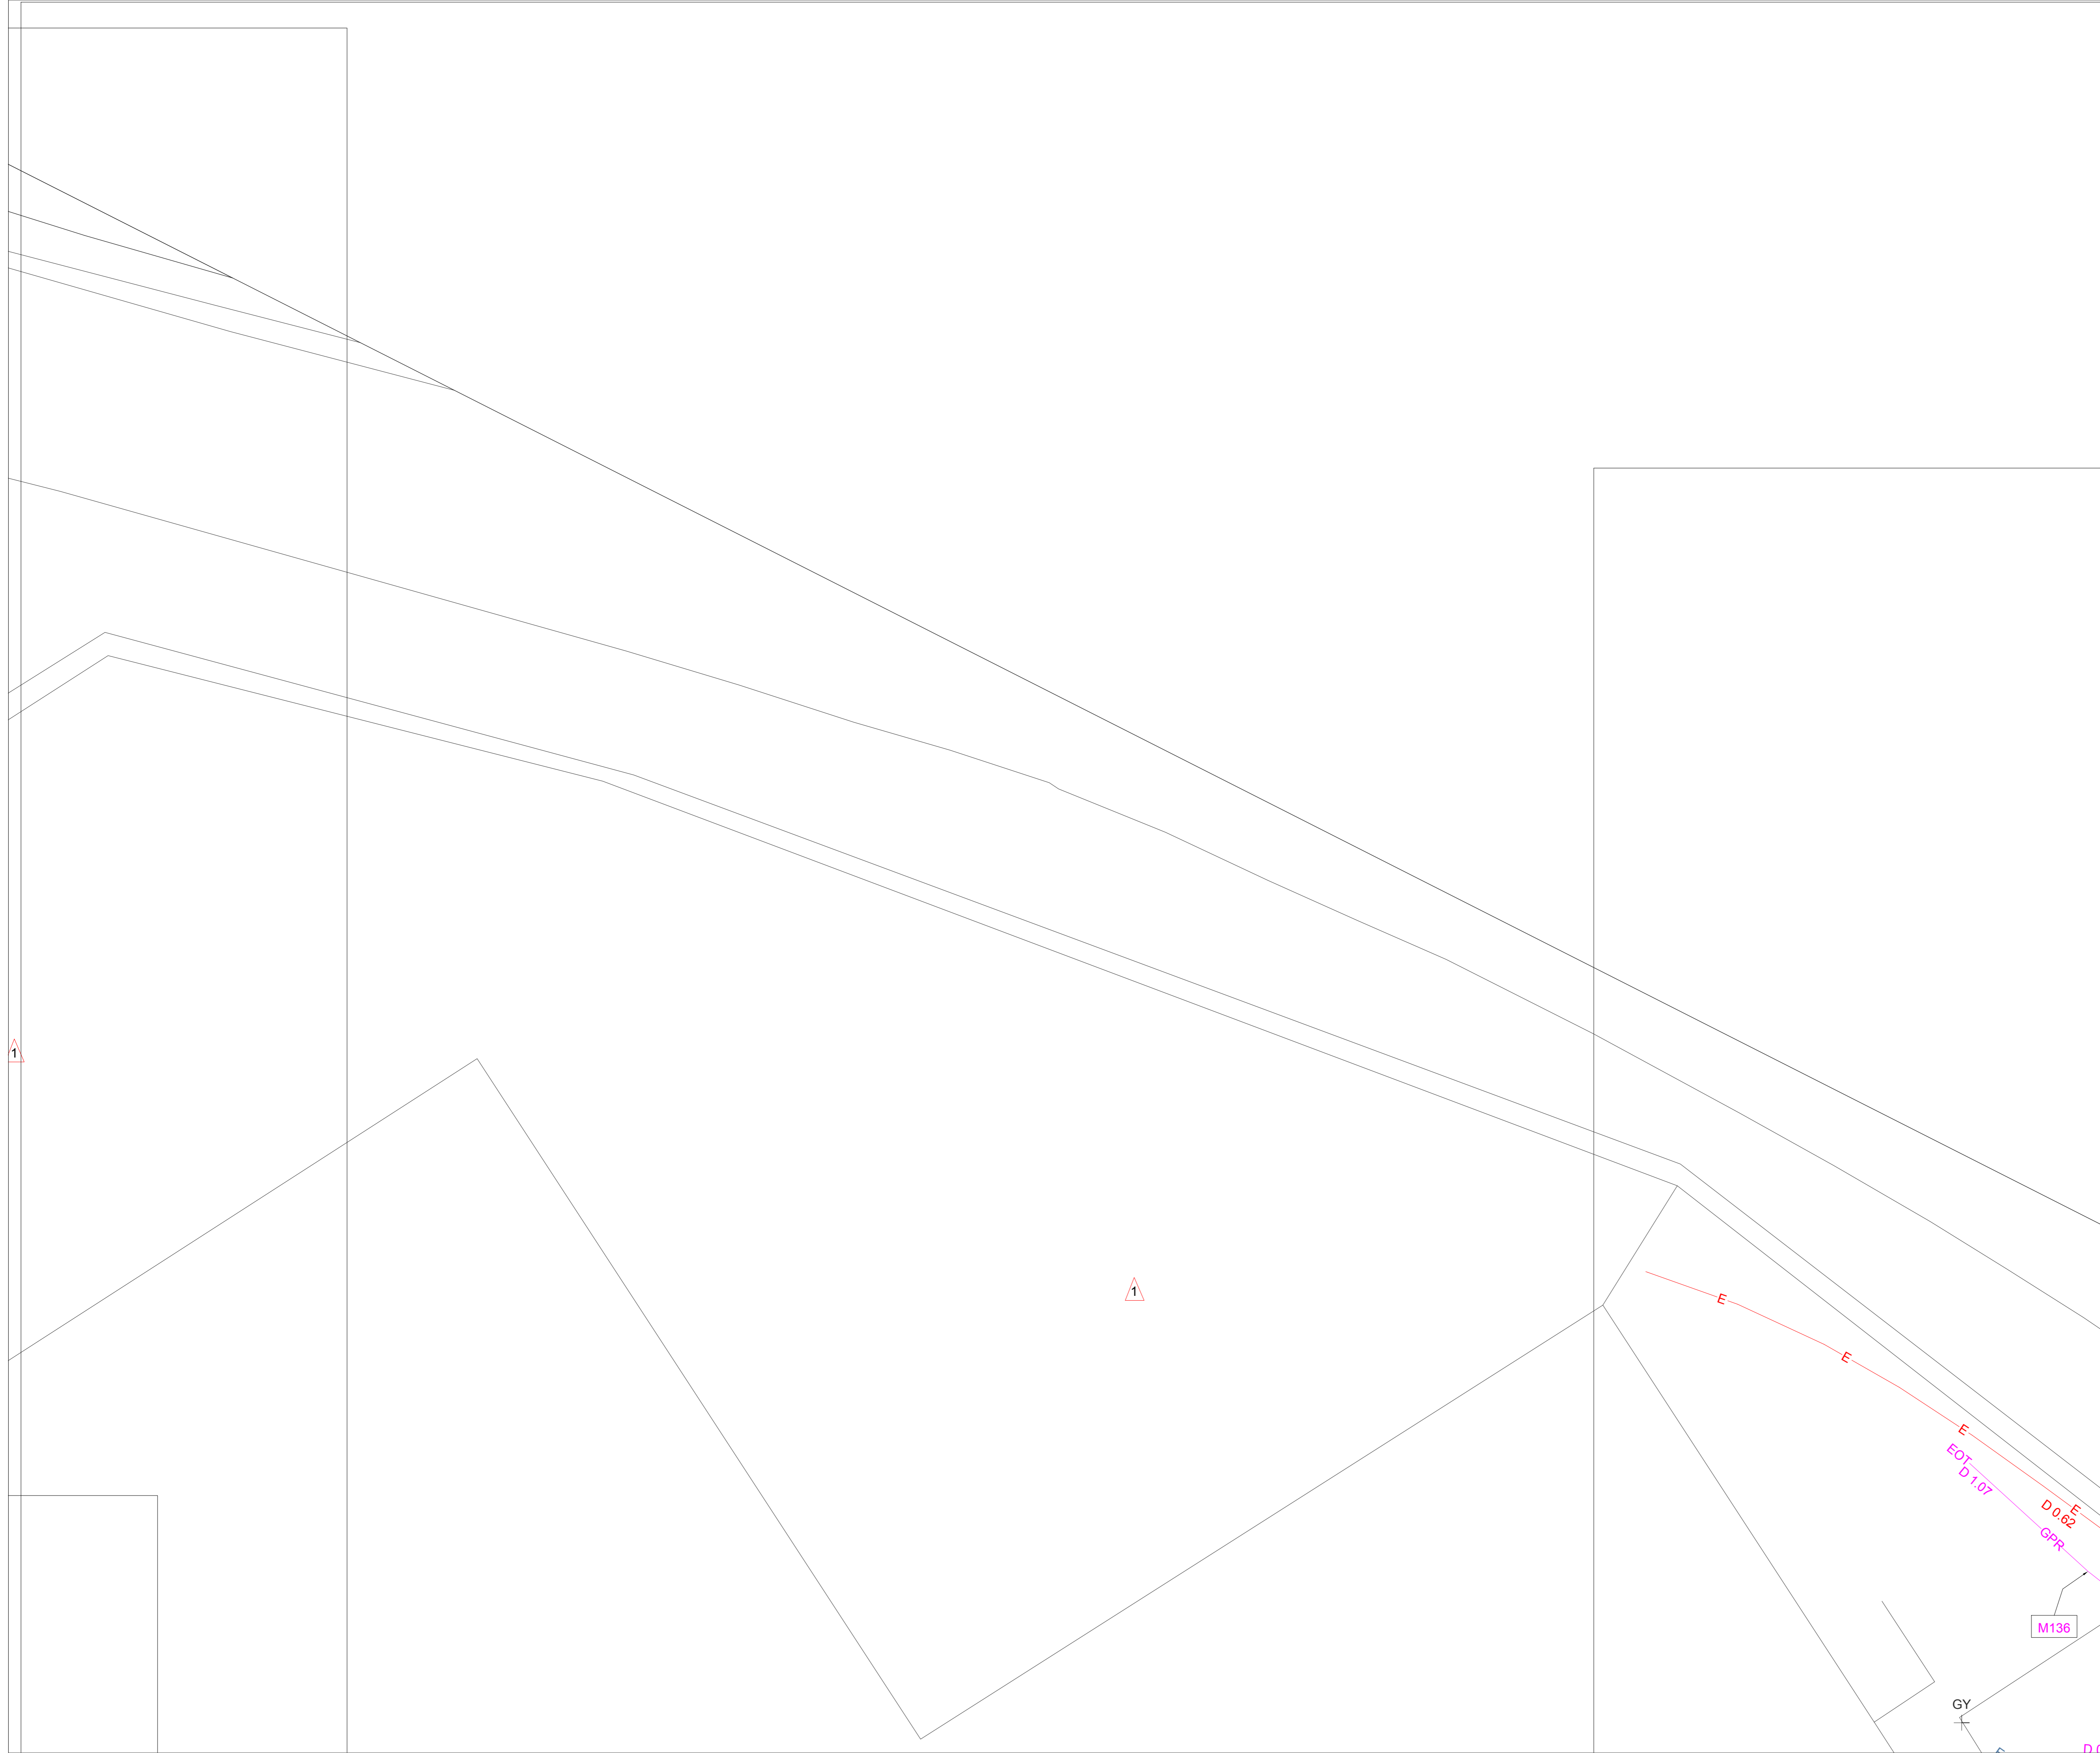

Appendix C – Existing Services Drawings

Refer to services table on the site drawings in Appendix B

Appendix D – Agreed Survey Area

For agreed survey area see boundary line indicated on site drawings in Appendix B

