



Notes

1. This drawing has been prepared in accordance with the scope of RPS's appointment with its client and is subject to the terms and conditions of that appointment. RPS accepts no liability for any use of this document other than by its client and only for the purposes for which it was prepared and provided.
2. If received electronically it is the recipients responsibility to print to correct scale. Only written dimensions should be used.
3. Where applicable Ordnance Survey (c) Crown Copyright 2019
All rights reserved. Licence number 0100031673

Key

-  Site Boundary
-  Desk Study Area



260 Park Avenue, Aztec West, Almondsbury,
Bristol BS32 4SY
T: 01454 853 000 E: rpssw@rpsgroup.com

Client **Aberfeldy New Village LLP**


Project **Aberfeldy Village Master Plan**

Title **Site Boundary and
Desk Study Area Locations**

Status	Drawn By	PM/Checked by
FINAL	MH	JL

Job Ref	Scale @ A3	Date Created
JER8921	NTS	July 2021

RPS Drawing / Figure Number	Rev
2	02

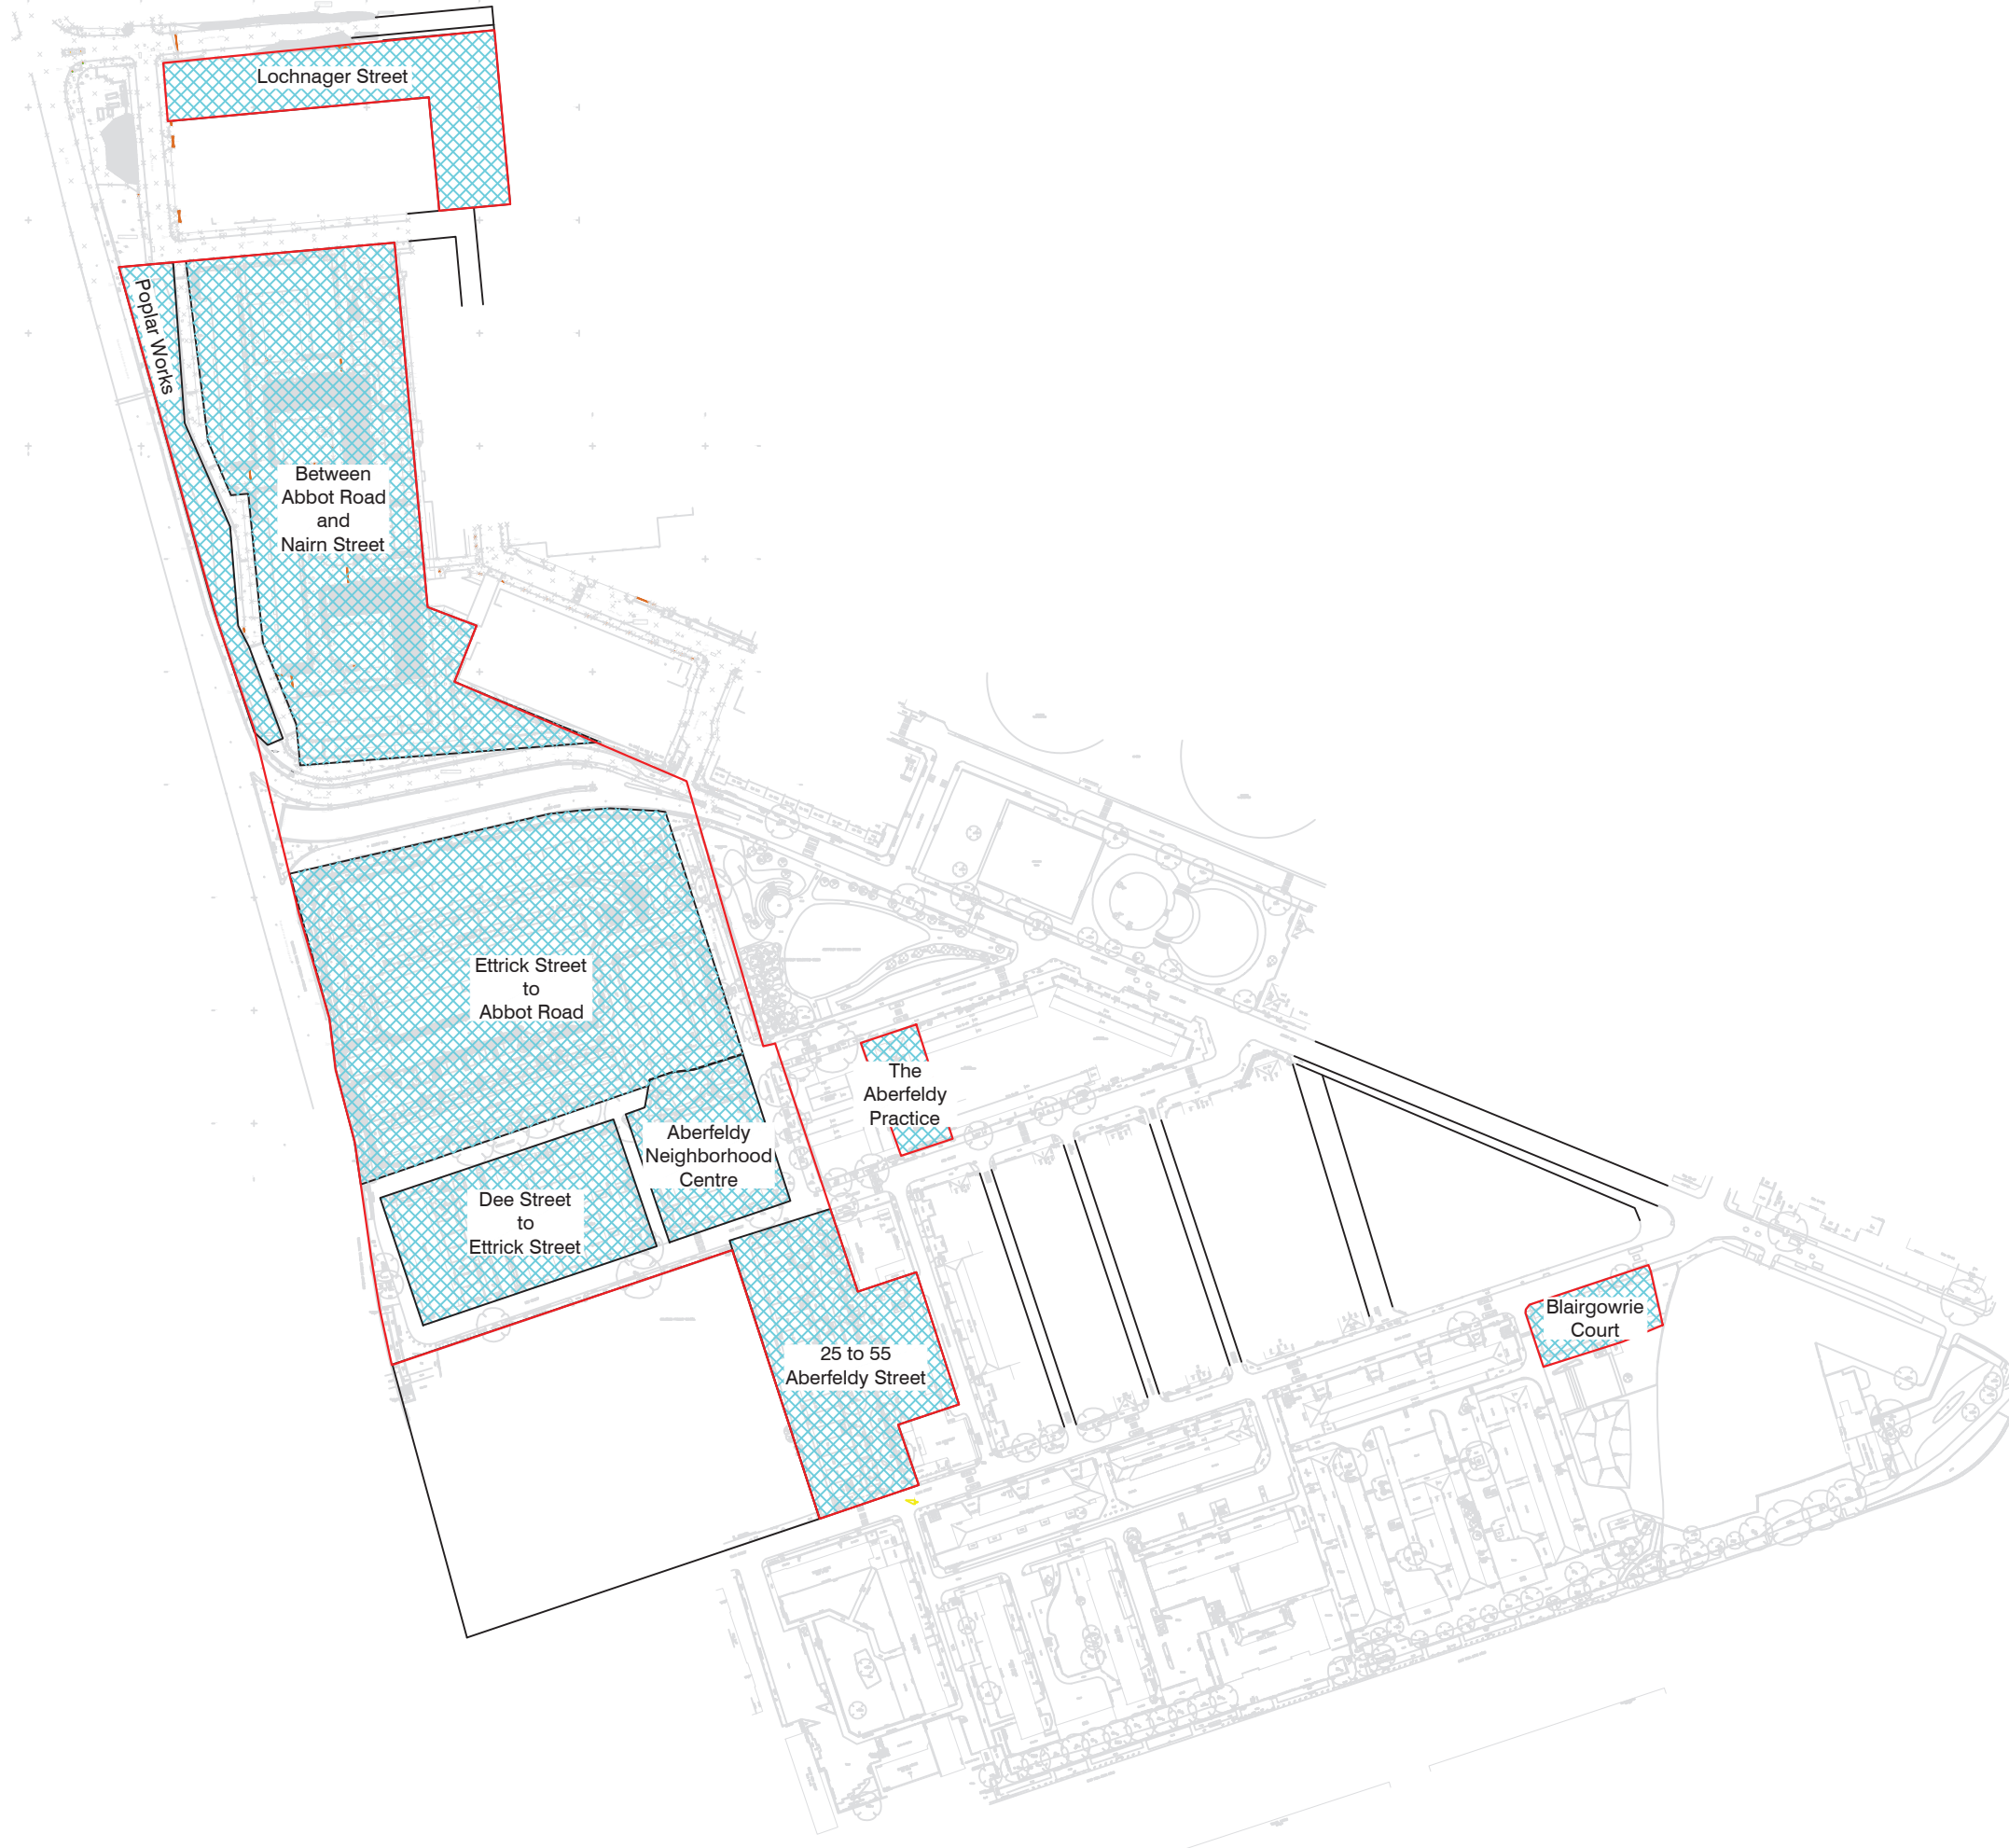



© 2019 RPS Group

Notes

1. This drawing has been prepared in accordance with the scope of RPS's appointment with its client and is subject to the terms and conditions of that appointment. RPS accepts no liability for any use of this document other than by its client and only for the purposes for which it was prepared and provided.
2. If received electronically it is the recipients responsibility to print to correct scale. Only written dimensions should be used.
3. Where applicable Ordnance Survey (c) Crown Copyright 2019
All rights reserved. Licence number 0100031673

Key

Site Boundary



260 Park Avenue, Aztec West, Almondsbury,
Bristol BS32 4SY
T: 01454 853 000 E: rpssw@rpsgroup.com

Client **Aberfeldy New Village LLP**

Project **Aberfeldy Village Master Plan**

Title **Current on Site Potential Sources of Contamination**

Status	Drawn By	PM/Checked by
FINAL	MH	JL

Job Ref	Scale @ A3	Date Created
JER8921	NTS	July 2021

RPS Drawing / Figure Number	Rev
3	03

rpsgroup.com

Appendices

Appendix A

Thames Water Asset Location Search

Asset location search



Meinhardt (UK) Ltd
10

LONDON
EC1A 4HJ

Search address supplied Aberfeldy Village
Aberfeldy Street
London
London
UK

Your reference Aberfeldy Street Aberfeldy Village E14 0NU

Our reference ALS/ALS Standard/2020_4292429

Search date 5 November 2020

Knowledge of features below the surface is essential for every development

The benefits of this knowledge not only include ensuring due diligence and avoiding risk, but also being able to ascertain the feasibility of any development.

Did you know that Thames Water Property Searches can also provide a variety of utility searches including a more comprehensive view of utility providers' assets (across up to 35-45 different providers), as well as more focused searches relating to specific major utility companies such as National Grid (gas and electric).

Contact us to find out more.



Thames Water Utilities Ltd
Property Searches, PO Box 3189, Slough SL1 4WW
DX 151280 Slough 13



searches@thameswater.co.uk
www.thameswater-propertysearches.co.uk



0845 070 9148

Search address supplied: Aberfeldy Village, Aberfeldy Street, London, London, UK,

Dear Sir / Madam

An Asset Location Search is recommended when undertaking a site development. It is essential to obtain information on the size and location of clean water and sewerage assets to safeguard against expensive damage and allow cost-effective service design.

The following records were searched in compiling this report: - the map of public sewers & the map of waterworks. Thames Water Utilities Ltd (TWUL) holds all of these.

This search provides maps showing the position, size of Thames Water assets close to the proposed development and also manhole cover and invert levels, where available.

Please note that none of the charges made for this report relate to the provision of Ordnance Survey mapping information. The replies contained in this letter are given following inspection of the public service records available to this company. No responsibility can be accepted for any error or omission in the replies.

You should be aware that the information contained on these plans is current only on the day that the plans are issued. The plans should only be used for the duration of the work that is being carried out at the present time. Under no circumstances should this data be copied or transmitted to parties other than those for whom the current work is being carried out.

Thames Water do update these service plans on a regular basis and failure to observe the above conditions could lead to damage arising to new or diverted services at a later date.

Contact Us

If you have any further queries regarding this enquiry please feel free to contact a member of the team on 0845 070 9148, or use the address below:

Thames Water Utilities Ltd
Property Searches
PO Box 3189
Slough
SL1 4WW

Email: searches@thameswater.co.uk

Web: www.thameswater-propertysearches.co.uk

Waste Water Services

Please provide a copy extract from the public sewer map.

The following quartiles have been printed as they fall within Thames' sewerage area:

TQ3881NE
TQ3881SW
TQ3881NW
TQ3881SE

Enclosed is a map showing the approximate lines of our sewers. Our plans do not show sewer connections from individual properties or any sewers not owned by Thames Water unless specifically annotated otherwise. Records such as "private" pipework are in some cases available from the Building Control Department of the relevant Local Authority.

Where the Local Authority does not hold such plans it might be advisable to consult the property deeds for the site or contact neighbouring landowners.

This report relates only to sewerage apparatus of Thames Water Utilities Ltd, it does not disclose details of cables and or communications equipment that may be running through or around such apparatus.

The sewer level information contained in this response represents all of the level data available in our existing records. Should you require any further information, please refer to the relevant section within the 'Further Contacts' page found later in this document.

For your guidance:

- The Company is not generally responsible for rivers, watercourses, ponds, culverts or highway drains. If any of these are shown on the copy extract they are shown for information only.
- Any private sewers or lateral drains which are indicated on the extract of the public sewer map as being subject to an agreement under Section 104 of the Water Industry Act 1991 are not an 'as constructed' record. It is recommended these details be checked with the developer.

Clean Water Services

Please provide a copy extract from the public water main map.

The following quartiles have been printed as they fall within Thames' water area:

TQ3881NE
TQ3881SW

TQ3881NW
TQ3881SE

Enclosed is a map showing the approximate positions of our water mains and associated apparatus. Please note that records are not kept of the positions of individual domestic supplies.

For your information, there will be a pressure of at least 10m head at the outside stop valve. If you would like to know the static pressure, please contact our Customer Centre on 0800 316 9800. The Customer Centre can also arrange for a full flow and pressure test to be carried out for a fee.

For your guidance:

- Assets other than vested water mains may be shown on the plan, for information only.
- If an extract of the public water main record is enclosed, this will show known public water mains in the vicinity of the property. It should be possible to estimate the likely length and route of any private water supply pipe connecting the property to the public water network.

Payment for this Search

A charge will be added to your suppliers account.



Further contacts:

Waste Water queries

Should you require verification of the invert levels of public sewers, by site measurement, you will need to approach the relevant Thames Water Area Network Office for permission to lift the appropriate covers. This permission will usually involve you completing a TWOSA form. For further information please contact our Customer Centre on Tel: 0845 920 0800. Alternatively, a survey can be arranged, for a fee, through our Customer Centre on the above number.

If you have any questions regarding sewer connections, budget estimates, diversions, building over issues or any other questions regarding operational issues please direct them to our service desk. Which can be contacted by writing to:

Developer Services (Waste Water)
Thames Water
Clearwater Court
Vastern Road
Reading
RG1 8DB


Tel: 0800 009 3921
Email: developer.services@thameswater.co.uk

Clean Water queries

Should you require any advice concerning clean water operational issues or clean water connections, please contact:

Developer Services (Clean Water)
Thames Water
Clearwater Court
Vastern Road
Reading
RG1 8DB

Tel: 0800 009 3921
Email: developer.services@thameswater.co.uk

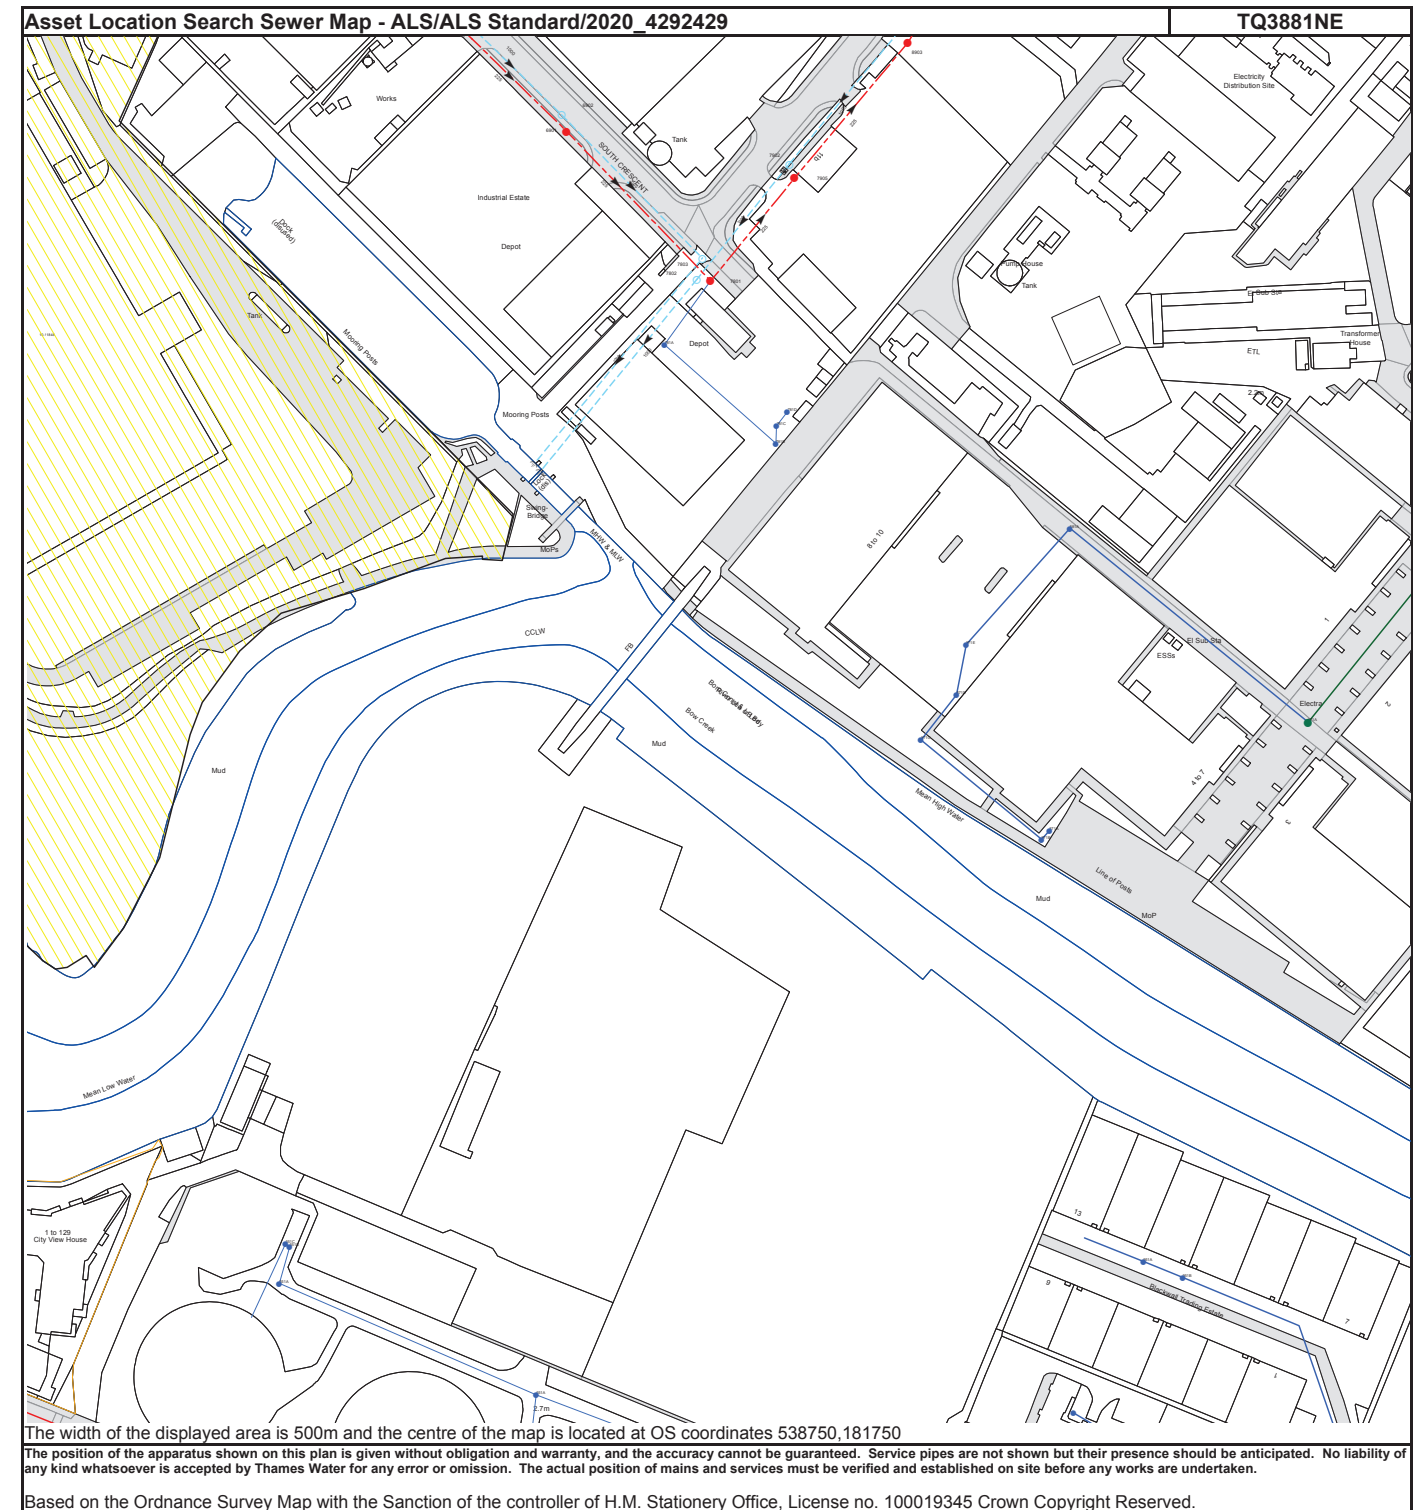


The width of the displayed area is 500m and the centre of the map is located at OS coordinates 538750,181750
The position of the apparatus shown on this plan is given without obligation and warranty, and the accuracy cannot be guaranteed. Service pipes are not shown but their presence should be anticipated. No liability of any kind whatsoever is accepted by Thames Water for any error or omission. The actual position of mains and services must be verified and established on site before any works are undertaken.
Based on the Ordnance Survey Map with the Sanction of the controller of H.M. Stationery Office, License no. 100019345 Crown Copyright Reserved.

NB. Levels quoted in metres Ordnance Newlyn Datum. The value -9999.00 indicates that no survey information is available

Manhole Reference	Manhole Cover Level	Manhole Invert Level
85AB	n/a	n/a
85AC	n/a	n/a
951A	n/a	n/a
951B	n/a	n/a
8904	n/a	n/a
8903	n/a	n/a
781A	n/a	n/a
7802	n/a	n/a
7803	n/a	n/a
7801	n/a	n/a
781B	n/a	n/a
781C	n/a	n/a
781D	n/a	n/a
871C	n/a	n/a
871D	n/a	n/a
871E	n/a	n/a
871B	n/a	n/a
871A	n/a	n/a
881A	n/a	n/a
971A	n/a	n/a
651A	n/a	n/a
6902	n/a	n/a
6901	n/a	n/a
7902	n/a	n/a
7905	n/a	n/a
551A	n/a	n/a
551C	n/a	n/a
551B	n/a	n/a

The position of the apparatus shown on this plan is given without obligation and warranty, and the accuracy cannot be guaranteed. Service pipes are not shown but their presence should be anticipated. No liability of any kind whatsoever is accepted by Thames Water for any error or omission. The actual position of mains and services must be verified and established on site before any works are undertaken.

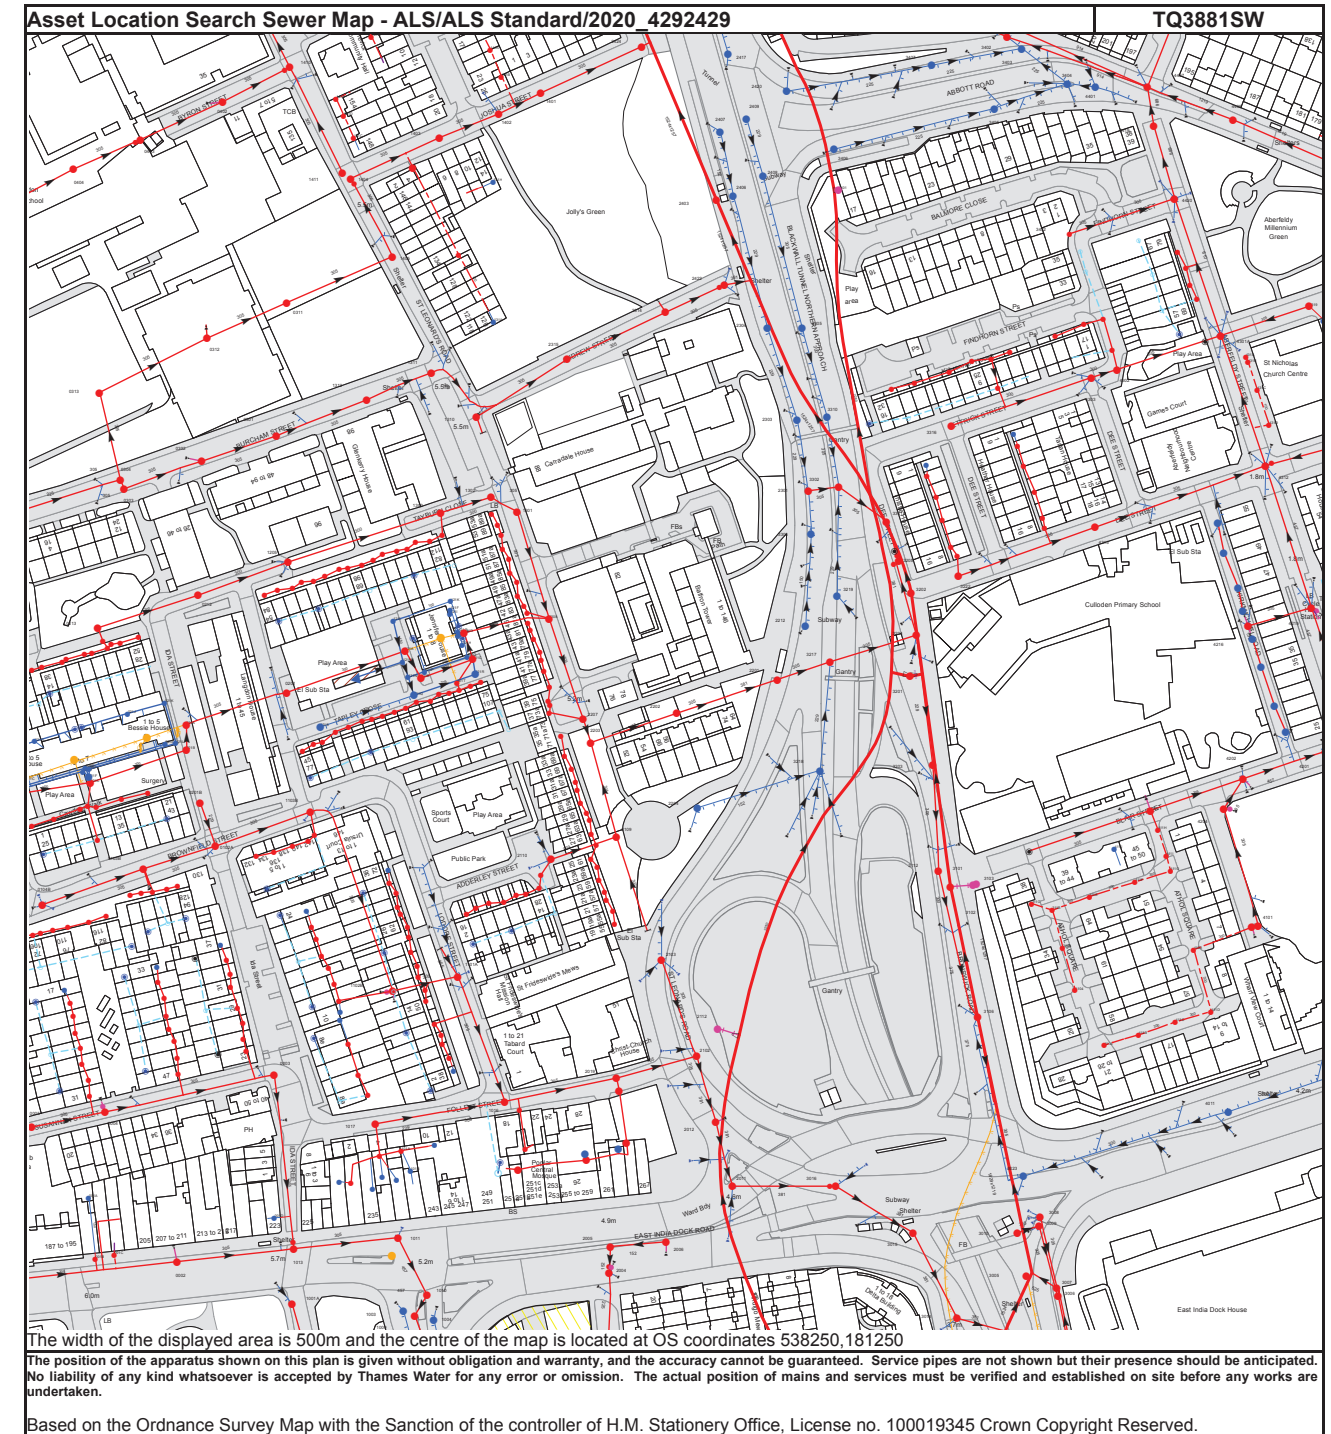

NB. Levels quoted in metres Ordnance Newlyn Datum. The value -9999.00 indicates that no survey information is available


Manhole Reference	Manhole Cover Level	Manhole Invert Level
3407	2.25	.86
3402	1.92	-3.79
3403	1.94	-.54
2417	3	1.5
141A	n/a	n/a
2424	2.32	n/a
141G	n/a	n/a
411H	n/a	n/a
4203	1.7	-.48
4204	1.79	-.7
4202	1.71	-.9
4201	1.7	-.94
42DH	n/a	n/a
42DI	n/a	n/a
42DJ	n/a	n/a
42EA	n/a	n/a
4216	1.57	-1.33
42EE	n/a	n/a
4215	1.61	-2.24
42EG	n/a	n/a
42ED	n/a	n/a
43DB	n/a	n/a
33CH	n/a	n/a
4301A	1.77	-2.82
43DE	n/a	n/a
431E	n/a	n/a
43DD	n/a	n/a
43DF	n/a	n/a
4319	1.76	-1.28
43DG	n/a	n/a
44DB	n/a	n/a
44DA	n/a	n/a
44CI	n/a	n/a
44DC	n/a	n/a
44DD	n/a	n/a
44CH	n/a	n/a
44CJ	n/a	n/a
3432	1.68	-1.72
4420	1.59	-3.16
4419	1.7	-3.27
4408	1.75	-3.45
3405	1.72	.13
4407	1.97	-3.55
4401	1.76	-.05
3404	1.67	-.33
3222	2.36	.55
32CG	n/a	n/a
42EC	n/a	n/a
33EE	n/a	n/a
4313	2.04	-1.04
43DI	n/a	n/a
33ED	n/a	n/a
33EC	n/a	n/a
33EB	n/a	n/a
4312	1.73	-2.54
33EA	n/a	n/a
33DJ	n/a	n/a
431D	n/a	n/a
431C	n/a	n/a
33CE	n/a	n/a
4303	n/a	n/a
4302	n/a	n/a
431B	n/a	n/a
33DB	n/a	n/a
33DC	n/a	n/a
431A	n/a	n/a
33DD	n/a	n/a
3016	4.41	-1.42
3015	4.08	-1.55
3014	3.45	-1.74
3010	n/a	n/a
3023	4.25	1.24
3005	n/a	n/a
3009	3.98	1.27
3008	4.06	2.68
3007	4.16	-1.23
3006	6.19	2.89
2422	2.26	-4.27
2406	2.7	1.83
2409	2.99	2.3
2408	n/a	n/a
2304	2.49	1.07
2420	3.36	1.54
2303	2.35	.8
2305	2.66	1.02
2301	2.38	.73
3306	2.49	1.72
3310	2.57	.74
3406	2.76	1.11
3401	3.04	-8.94

Manhole Reference	Manhole Cover Level	Manhole Invert Level
3302	2.7	.54
3301B	2.29	-1.11
33CI	n/a	n/a
3205	2.35	-4.07
33CD	n/a	n/a
3202	n/a	n/a
33CJ	n/a	n/a
33DE	n/a	n/a
33DF	n/a	n/a
33DG	n/a	n/a
33DH	n/a	n/a
33DA	n/a	n/a
33DI	n/a	n/a
3316	n/a	n/a
2102	4.37	1.67
2012	4.38	1.37
2112	4.66	-8.47
3112	n/a	n/a
3101	n/a	n/a
3102	n/a	n/a
3103	n/a	n/a
3106	n/a	n/a
311C	n/a	n/a
311B	n/a	n/a
311A	n/a	n/a
4104	1.72	-.02
411E	n/a	n/a
411A	n/a	n/a
411J	n/a	n/a
411F	n/a	n/a
411B	n/a	n/a
411I	n/a	n/a
411G	n/a	n/a
411C	n/a	n/a
4103	1.85	-.11
411D	n/a	n/a
4011	4.17	1.55
4102	1.93	-.22
4101	1.93	-.49
12BD	n/a	n/a
12BE	n/a	n/a
2208	5.19	2.74
22CE	n/a	n/a
22CD	n/a	n/a
12BF	n/a	n/a
22BH	n/a	n/a
22BI	n/a	n/a
22BJ	n/a	n/a
22CA	n/a	n/a
22CB	n/a	n/a
22CC	n/a	n/a
2207	5.18	2.47
21CE	n/a	n/a
21CD	n/a	n/a
2203	5.2	2.35
21CC	n/a	n/a
2202	3.7	1.85
2204	3.93	2.12
2201	2.97	.77
2212	2.64	1.93
3218	2.85	1.21
3217	2.94	.53
3219	2.74	1.64
3201	2.44	-8.63
3204	2.34	-.83
3203	2.47	-1.25
12EB	n/a	n/a
12EA	n/a	n/a
121I	n/a	n/a
121F	5.7	4.88
121K	5.65	4.88
121T	5.98	3.89
121J	n/a	n/a
121G	5.7	4.55
12DJ	n/a	n/a
121E	n/a	n/a
121H	n/a	n/a
121D	5.7	3.04
121O	6.31	4.9
12DI	n/a	n/a
121C	5.99	3.08
121R	6.17	4.07
12DH	n/a	n/a
12FH	n/a	n/a
12FI	n/a	n/a
12BJ	n/a	n/a
12CA	n/a	n/a
12CB	n/a	n/a
12AI	n/a	n/a
12AJ	n/a	n/a
12BA	n/a	n/a
12BB	n/a	n/a
12BC	n/a	n/a

Manhole Reference	Manhole Cover Level	Manhole Invert Level
11ED	n/a	n/a
11EC	n/a	n/a
11EB	n/a	n/a
21BE	n/a	n/a
11CG	n/a	n/a
11EA	n/a	n/a
21CH	n/a	n/a
21BF	n/a	n/a
11CH	n/a	n/a
11DJ	n/a	n/a
11CI	n/a	n/a
11CJ	n/a	n/a
21BG	n/a	n/a
11DA	n/a	n/a
11DB	n/a	n/a
11DI	n/a	n/a
21BH	n/a	n/a
11DC	n/a	n/a
11DH	n/a	n/a
21BI	n/a	n/a
11DF	n/a	n/a
11DG	n/a	n/a
21BJ	n/a	n/a
2110	5.27	3.03
21CA	n/a	n/a
21CB	n/a	n/a
2109	4.66	2.72
10DF	n/a	n/a
20DC	n/a	n/a
101A	n/a	n/a
20CD	n/a	n/a
10CC	n/a	n/a
10CI	n/a	n/a
20CI	n/a	n/a
1017	5.67	2.64
10CD	n/a	n/a
1016	5.23	2.03
10FD	n/a	n/a
20CJ	n/a	n/a
2019	4.77	1.79
10FE	n/a	n/a
11EI	n/a	n/a
11EJ	n/a	n/a
11FA	n/a	n/a
11FB	n/a	n/a
11FC	n/a	n/a
11FE	n/a	n/a
11FH	n/a	n/a
1102B	5.81	2.58
11EG	n/a	n/a
11EF	n/a	n/a
1101A	5.8	2.17
11EE	n/a	n/a
2103	4.5	2.19
02CH	n/a	n/a
12GD	n/a	n/a
12DG	n/a	n/a
12BI	n/a	n/a
12DF	n/a	n/a
12DD	n/a	n/a
12DC	n/a	n/a
12BH	n/a	n/a
12DB	n/a	n/a
12DA	n/a	n/a
12CJ	n/a	n/a
12GF	n/a	n/a
1205	n/a	n/a
12CI	n/a	n/a
12BG	n/a	n/a
12CH	n/a	n/a
12CC	n/a	n/a
13DH	n/a	n/a
13DE	n/a	n/a
13DG	n/a	n/a
13DF	n/a	n/a
13DD	n/a	n/a
13DI	n/a	n/a
13DC	n/a	n/a
13DB	n/a	n/a
1303	n/a	n/a
1301	5.33	3.16
1004	n/a	n/a
1009	n/a	n/a
1003	n/a	n/a
1001A	n/a	n/a
1010	5.03	1.14
2004	5.3	2.58
1013	5.52	1.82
2005	4.86	3.56
2006	4.74	3.75
1011	5.33	1.55
001D	n/a	n/a
10DH	n/a	n/a

Manhole Reference	Manhole Cover Level	Manhole Invert Level
2011	4.53	1.22
10FA	n/a	n/a
10EJ	n/a	n/a
10DG	n/a	n/a
10DE	n/a	n/a
10DB	n/a	n/a
101B	n/a	n/a
10DD	n/a	n/a
20DB	n/a	n/a
01FD	n/a	n/a
0102A	6.44	3.38
01FG	n/a	n/a
01FH	n/a	n/a
01FI	n/a	n/a
01FJ	n/a	n/a
01FF	n/a	n/a
01GA	n/a	n/a
01GB	n/a	n/a
01GC	n/a	n/a
01BE	n/a	n/a
01BF	n/a	n/a
0003	6.02	2.89
11CB	n/a	n/a
11GI	n/a	n/a
11GA	n/a	n/a
11CC	n/a	n/a
11GB	n/a	n/a
11GC	n/a	n/a
11GD	n/a	n/a
11GE	n/a	n/a
11GF	n/a	n/a
11GG	n/a	n/a
10FC	n/a	n/a
11HC	n/a	n/a
11HA	n/a	n/a
11HD	n/a	n/a
0302	5.99	3.98
0312	n/a	2.95
0402	5.17	2.45
0301	5.75	3.69
0311	5.81	2.78
1410	5.02	1.25
141E	n/a	n/a
1411	5.23	1.47
141D	n/a	n/a
1404	5.25	1.53
141C	n/a	n/a
1312	5.55	3.33
1405	5.47	2.46
1415	n/a	n/a
1311	5.43	2.97
1403	4.55	1.3
1414	n/a	n/a
1310	5.38	3.07
1302	n/a	n/a
141H	n/a	n/a
131A	n/a	n/a
1402	4.17	1.17
141B	n/a	n/a
1401	3.58	1.08
2315	4.46	1.69
2314	3.26	1.25
2403	2.27	-5.19
2407	2.81	2.25
0212	n/a	n/a
0201B	6.49	3.67
02CI	n/a	n/a
0202	6.24	3.38
12FD	n/a	n/a
1103B	5.94	3.13
12FC	n/a	n/a
11CD	n/a	n/a
121S	6.11	5.25
12FB	n/a	n/a
12FA	n/a	n/a
12EJ	n/a	n/a
12EI	n/a	n/a
12EH	n/a	n/a
12EG	n/a	n/a
121L	5.71	4.55
12EF	n/a	n/a
121M	5.73	4.28
121A	5.6	3.17
12EE	n/a	n/a

The position of the apparatus shown on this plan is given without obligation and warranty, and the accuracy cannot be guaranteed. Service pipes are not shown but their presence should be anticipated. No liability of any kind whatsoever is accepted by Thames Water for any error or omission. The actual position of mains and services must be verified and established on site before any works are undertaken.

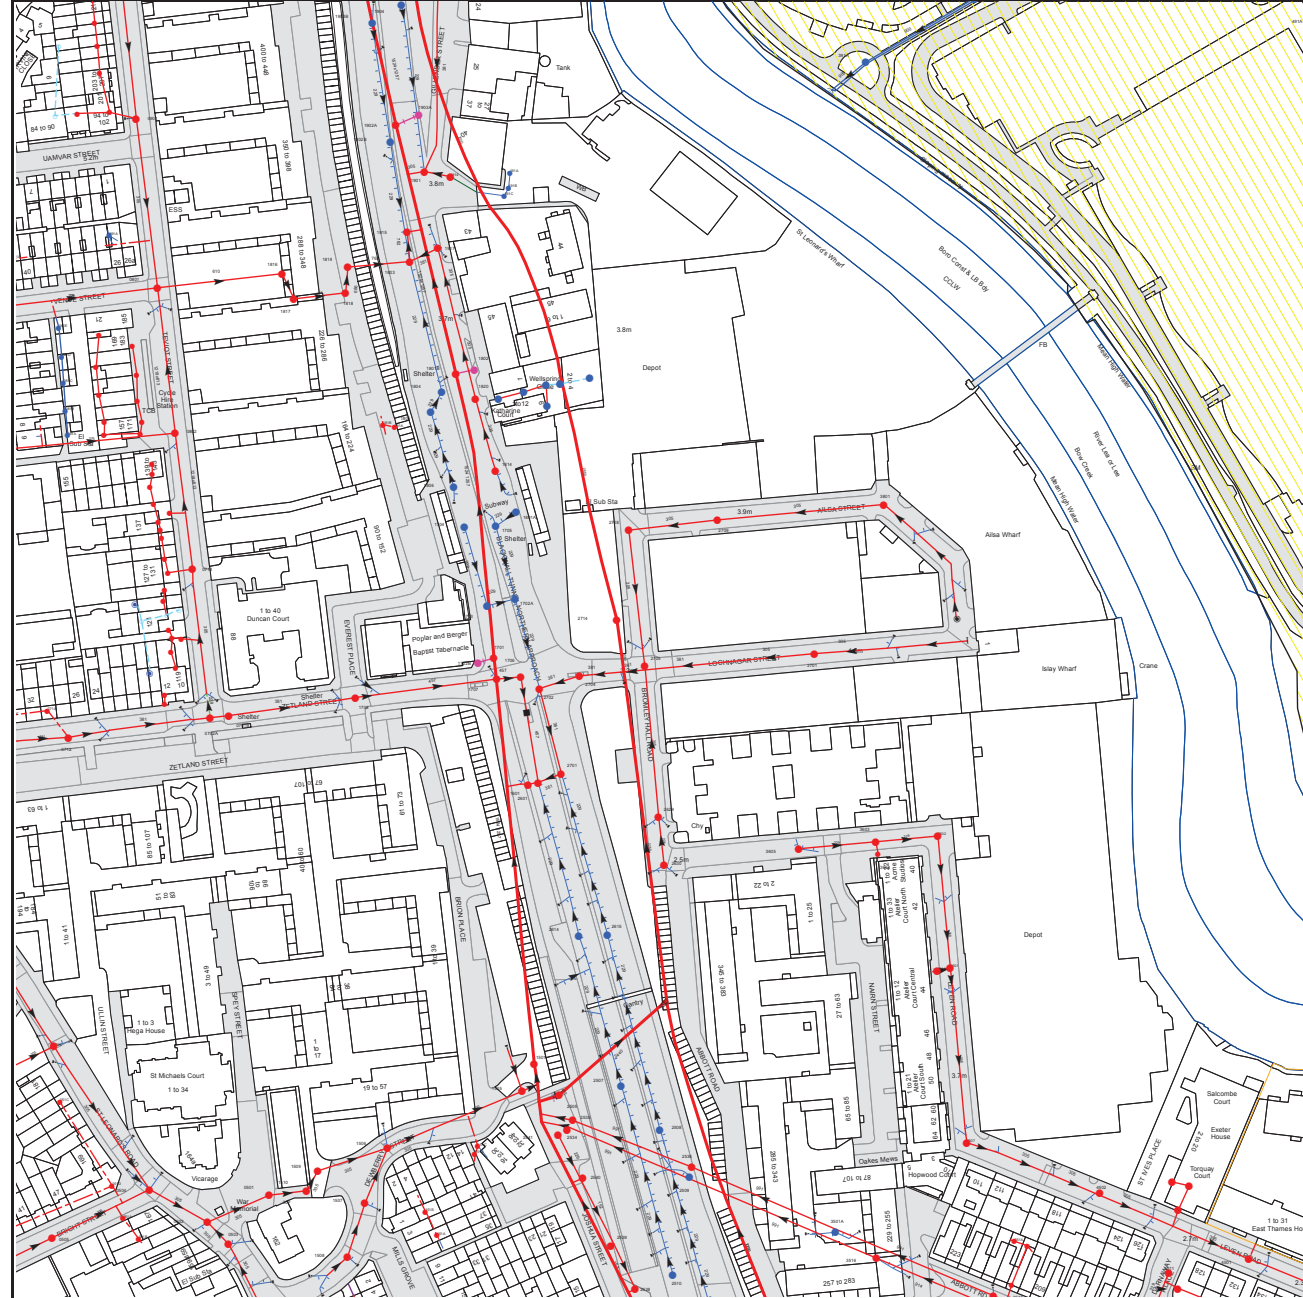


The width of the displayed area is 500m and the centre of the map is located at OS coordinates 538250,181750
 The position of the apparatus shown on this plan is given without obligation and warranty, and the accuracy cannot be guaranteed. Service pipes are not shown but their presence should be anticipated. No liability of any kind whatsoever is accepted by Thames Water for any error or omission. The actual position of mains and services must be verified and established on site before any works are undertaken.
 Based on the Ordnance Survey Map with the Sanction of the controller of H.M. Stationery Office, License no. 100019345 Crown Copyright Reserved.

NB. Levels quoted in metres Ordnance Newlyn Datum. The value -9999.00 indicates that no survey information is available

Manhole Reference	Manhole Cover Level	Manhole Invert Level
3701	n/a	n/a
3501A	n/a	n/a
3603	3.19	1.1
3516	n/a	n/a
3604	3.24	n/a
361A	3.5	.4
3602	3.75	.78
3601	3.55	.29
3507	3.39	n/a
3517	n/a	n/a
35CH	n/a	n/a
351A	n/a	n/a
35CG	n/a	n/a
4502	n/a	n/a
4511	n/a	n/a
45BF	n/a	n/a
45CB	n/a	n/a
45BH	n/a	n/a
45BG	n/a	n/a
4501	n/a	n/a
1705	n/a	n/a
2709	n/a	n/a
1801A	n/a	n/a
3801	n/a	n/a
1806	n/a	n/a
1814	n/a	n/a
181A	n/a	n/a
181B	n/a	n/a
1805	n/a	n/a
28AB	n/a	n/a
18CI	n/a	n/a
1820	n/a	n/a
18CH	n/a	n/a
1804	n/a	n/a
28AC	n/a	n/a
28AE	n/a	n/a
28AD	n/a	n/a
1801B	n/a	n/a
1802	n/a	n/a
1817	n/a	n/a
1818	n/a	n/a
1816	n/a	n/a
1819	n/a	n/a
1803	n/a	n/a
1917	n/a	n/a
1915	n/a	n/a
191C	n/a	n/a
191B	n/a	n/a
1914	n/a	n/a
191A	n/a	n/a
1901	n/a	n/a
1902B	n/a	n/a
1902A	n/a	n/a
1903A	n/a	n/a
391A	n/a	n/a
1903B	n/a	n/a
491A	n/a	n/a
1904	n/a	n/a
391B	n/a	n/a
2538	n/a	n/a
2510	n/a	n/a
1508	n/a	n/a
2539	n/a	n/a
0503	n/a	n/a
151A	n/a	n/a
0502	n/a	n/a
151B	n/a	n/a
1507	n/a	n/a
0501	n/a	n/a
1510	n/a	n/a
2540	n/a	n/a
2509	n/a	n/a
1509	n/a	n/a
2536	n/a	n/a
151D	n/a	n/a
1506	n/a	n/a
151C	n/a	n/a
2541	n/a	n/a
2534	n/a	n/a
2508	n/a	n/a
2535	n/a	n/a
2505	2.25	-8.8
1505	n/a	n/a
2507	n/a	n/a
1501	2.32	-5.24
2614	n/a	n/a
2615	n/a	n/a
2630	n/a	n/a
3605	n/a	n/a
2629	n/a	n/a

Manhole Reference	Manhole Cover Level	Manhole Invert Level
1601	n/a	n/a
2601	n/a	n/a
2701	n/a	n/a
0702A	n/a	n/a
0701B	n/a	n/a
1708	n/a	n/a
2702	n/a	n/a
1707	n/a	n/a
1706	n/a	n/a
2704	n/a	n/a
2705	n/a	n/a
1702B	n/a	n/a
1701	n/a	n/a
2714	3.24	-9.46
1703	n/a	n/a
1702A	n/a	n/a
0713	n/a	n/a
2708	n/a	n/a
1704	n/a	n/a
07CH	n/a	n/a
07DB	n/a	n/a
07DD	n/a	n/a
07DE	n/a	n/a
07DJ	n/a	n/a
07EA	n/a	n/a
07EB	n/a	n/a
07DI	n/a	n/a
07DH	n/a	n/a
08BJ	n/a	n/a
08CA	n/a	n/a
08CB	n/a	n/a
08CC	n/a	n/a
08AH	n/a	n/a
081A	n/a	n/a
08EE	n/a	n/a
08DI	n/a	n/a
0802	n/a	n/a
08DH	n/a	n/a
08ED	n/a	n/a
081B	n/a	n/a
08DG	n/a	n/a
08EC	n/a	n/a
081C	n/a	n/a
08DF	n/a	n/a
08EB	n/a	n/a
081D	n/a	n/a
08DE	n/a	n/a
08EA	n/a	n/a
081E	n/a	n/a
0801	n/a	n/a
091A	n/a	n/a
0901	n/a	n/a
09BD	n/a	n/a
09BE	n/a	n/a
09BF	n/a	n/a
09CA	n/a	n/a
09BJ	n/a	n/a
09BC	n/a	n/a
09BI	n/a	n/a
09BH	n/a	n/a
071A	n/a	n/a
0506	n/a	n/a
051C	n/a	n/a
0712	n/a	n/a
051D	n/a	n/a
07CI	n/a	n/a
0504	n/a	n/a
07AH	n/a	n/a
07BJ	n/a	n/a
07CE	n/a	n/a
07CF	n/a	n/a
07CD	n/a	n/a
07CG	n/a	n/a
07CC	n/a	n/a
051B	n/a	n/a
0505	n/a	n/a
051A	n/a	n/a

The position of the apparatus shown on this plan is given without obligation and warranty, and the accuracy cannot be guaranteed. Service pipes are not shown but their presence should be anticipated. No liability of any kind whatsoever is accepted by Thames Water for any error or omission. The actual position of mains and services must be verified and established on site before any works are undertaken.

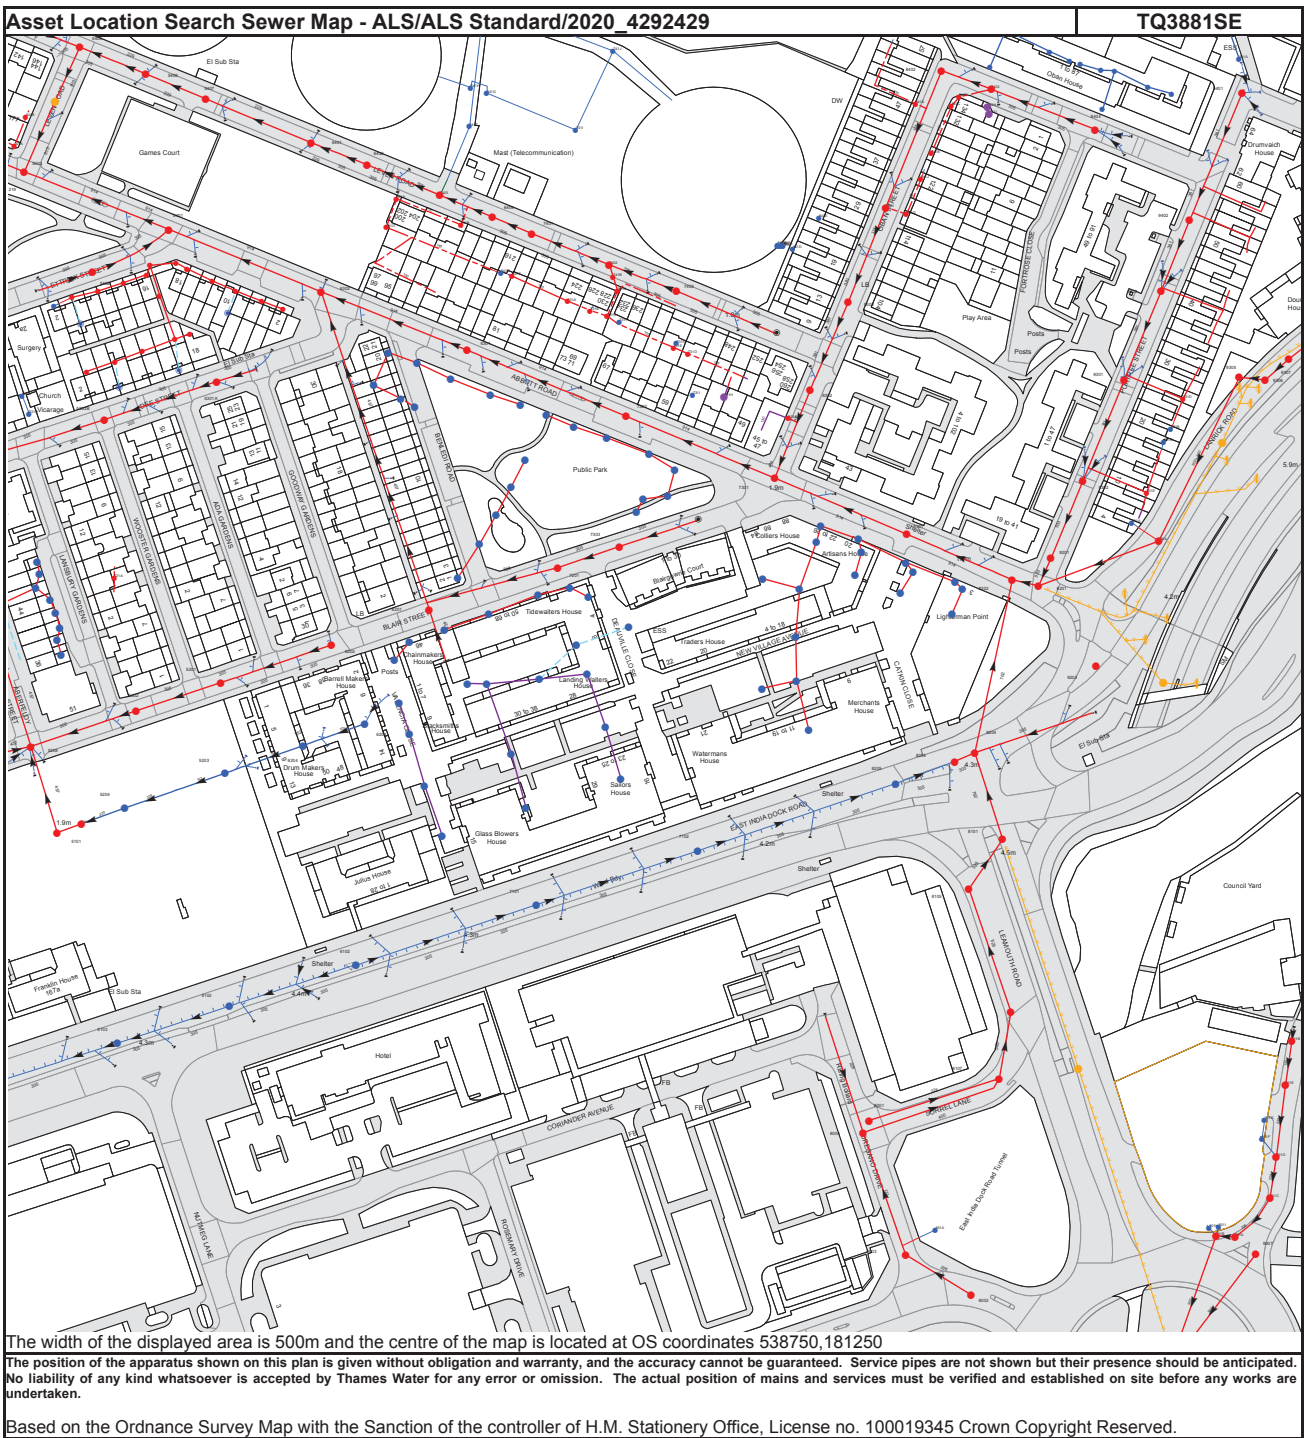

The width of the displayed area is 500m and the centre of the map is located at OS coordinates 538750,181250
The position of the apparatus shown on this plan is given without obligation and warranty, and the accuracy cannot be guaranteed. Service pipes are not shown but their presence should be anticipated. No liability of any kind whatsoever is accepted by Thames Water for any error or omission. The actual position of mains and services must be verified and established on site before any works are undertaken.
Based on the Ordnance Survey Map with the Sanction of the controller of H.M. Stationery Office, License no. 100019345 Crown Copyright Reserved.

NB. Levels quoted in metres Ordnance Newlyn Datum. The value -9999.00 indicates that no survey information is available

Manhole Reference	Manhole Cover Level	Manhole Invert Level
8401	n/a	n/a
841G	n/a	n/a
841A	n/a	n/a
841J	n/a	n/a
841B	n/a	n/a
8402	n/a	n/a
841C	n/a	n/a
841F	n/a	n/a
841H	n/a	n/a
841I	n/a	n/a
84DH	n/a	n/a
8403	n/a	n/a
94CI	n/a	n/a
94CH	n/a	n/a
94CJ	n/a	n/a
9404	n/a	n/a
94DA	n/a	n/a
94DC	n/a	n/a
94DB	n/a	n/a
9402	n/a	n/a
9401	n/a	n/a
7403	n/a	n/a
741A	n/a	n/a
741B	n/a	n/a
641C	n/a	n/a
641E	n/a	n/a
7402	n/a	n/a
841D	n/a	n/a
741E	n/a	n/a
741D	n/a	n/a
741H	n/a	n/a
741C	n/a	n/a
741G	n/a	n/a
741F	n/a	n/a
7401	n/a	n/a
641D	n/a	n/a
641B	n/a	n/a
841E	n/a	n/a
6404	n/a	n/a
641A	n/a	n/a
6403	n/a	n/a
6402	n/a	n/a
741I	n/a	n/a
641F	n/a	n/a
641G	n/a	n/a
641H	n/a	n/a
741J	n/a	n/a
5405	n/a	n/a
9203	n/a	n/a
82CD	n/a	n/a
82CH	n/a	n/a
82CE	n/a	n/a
8201	n/a	n/a
82CF	n/a	n/a
8202	n/a	n/a
82CJ	n/a	n/a
82CI	n/a	n/a
82CG	n/a	n/a
9201	n/a	n/a
83CF	n/a	n/a
9304	n/a	n/a
83CE	n/a	n/a
8301	n/a	n/a
931A	n/a	n/a
931E	n/a	n/a
9302	n/a	n/a
931C	n/a	n/a
931B	n/a	n/a
931D	n/a	n/a
9301	n/a	n/a
9306	n/a	n/a
9305	n/a	n/a
9307	n/a	n/a
9403	n/a	n/a
72AI	n/a	n/a
731B	n/a	n/a
73CI	n/a	n/a
731C	n/a	n/a
731F	n/a	n/a
7303	n/a	n/a
7302	n/a	n/a
72CD	n/a	n/a
73DD	n/a	n/a
73DB	n/a	n/a
73CG	n/a	n/a
73DA	n/a	n/a
731E	n/a	n/a
73CJ	n/a	n/a
731G	n/a	n/a
731D	n/a	n/a

Manhole Reference	Manhole Cover Level	Manhole Invert Level
731I	n/a	n/a
731H	n/a	n/a
72AH	n/a	n/a
7301	n/a	n/a
831A	n/a	n/a
82CB	n/a	n/a
82CC	n/a	n/a
8302	n/a	n/a
83CB	n/a	n/a
83CC	n/a	n/a
8303	n/a	n/a
8004	n/a	n/a
8003	n/a	n/a
801A	6.29	5.79
8002	n/a	n/a
9007	n/a	n/a
8001	n/a	n/a
8107	n/a	n/a
8106	n/a	n/a
6102	n/a	n/a
7101	n/a	n/a
8105	n/a	n/a
7102	n/a	n/a
8101	n/a	n/a
61BC	n/a	n/a
62DF	n/a	n/a
62CJ	n/a	n/a
8205	n/a	n/a
72CB	n/a	n/a
8206	n/a	n/a
62DE	n/a	n/a
8204	n/a	n/a
62DA	n/a	n/a
82BJ	n/a	n/a
72CA	n/a	n/a
6203	n/a	n/a
62DB	n/a	n/a
72AG	n/a	n/a
62DD	n/a	n/a
62DC	n/a	n/a
82CA	n/a	n/a
72BJ	n/a	n/a
72BI	n/a	n/a
6202	n/a	n/a
63DI	n/a	n/a
63DJ	n/a	n/a
62CA	n/a	n/a
63EI	n/a	n/a
62CB	n/a	n/a
63FA	n/a	n/a
63EA	n/a	n/a
6201	n/a	n/a
62CE	n/a	n/a
63ED	n/a	n/a
62EF	n/a	n/a
6301	n/a	n/a
63EG	n/a	n/a
62CD	n/a	n/a
63EC	n/a	n/a
63EF	n/a	n/a
63EH	n/a	n/a
63EB	n/a	n/a
63EE	n/a	n/a
72BA	n/a	n/a
73CF	n/a	n/a
7201	n/a	n/a
731A	n/a	n/a
72AJ	n/a	n/a
73CH	n/a	n/a
72CC	n/a	n/a
53AE	n/a	n/a
53BG	n/a	n/a
53BH	n/a	n/a
5402	n/a	n/a
54DI	n/a	n/a
5302B	n/a	n/a
521A	n/a	n/a
53BI	n/a	n/a
54BH	n/a	n/a
53BJ	n/a	n/a
5406	n/a	n/a
54DH	n/a	n/a
54DJ	n/a	n/a
53CC	n/a	n/a
5401	n/a	n/a
53CA	n/a	n/a
54EA	n/a	n/a
54EB	n/a	n/a
53CB	n/a	n/a
5407	n/a	n/a
54EC	n/a	n/a
5301A	n/a	n/a
54ED	n/a	n/a

Manhole Reference	Manhole Cover Level	Manhole Invert Level
53CD	n/a	n/a
63CF	n/a	n/a
6401	n/a	n/a
6302	n/a	n/a
5101	n/a	n/a
511B	n/a	n/a
5204	n/a	n/a
5203	n/a	n/a
5205	n/a	n/a
6204	n/a	n/a
5202	n/a	n/a
5201	n/a	n/a
52CH	n/a	n/a
52CI	n/a	n/a
52CJ	n/a	n/a
52DA	n/a	n/a
52DB	n/a	n/a
5403	n/a	n/a
541A	n/a	n/a
541B	n/a	n/a
52DC	n/a	n/a
52DE	n/a	n/a
52DD	n/a	n/a
531B	n/a	n/a
531A	n/a	n/a
5103	n/a	n/a
5102	n/a	n/a
901H	5.1	4.21
901B	2.1	2.1
901I	5.1	4.39
901A	4.91	2.2
901F	5.59	4.52
901G	5.59	2.97
901C	4.96	2.37
901D	4.82	2.43
901E	4.68	2.58
911B	4.6	3.15
94DF	n/a	n/a
94DE	n/a	n/a
941A	n/a	n/a

The position of the apparatus shown on this plan is given without obligation and warranty, and the accuracy cannot be guaranteed. Service pipes are not shown but their presence should be anticipated. No liability of any kind whatsoever is accepted by Thames Water for any error or omission. The actual position of mains and services must be verified and established on site before any works are undertaken.

Thames Water ALS Sewer Map Key

Public Sewer Types (Operated & Maintained by Thames Water)

- Foul:** A sewer designed to convey waste water from domestic and industrial sources to a treatment works.
- Surface Water:** A sewer designed to convey surface water (e.g. rain water from roofs, yards and car parks) to rivers or watercourses.
- Combined:** A sewer designed to convey both waste water and surface water from domestic and industrial sources to a treatment works.

Sewer Fittings

A feature in a sewer that does not affect the flow in the pipe. Example: a vent is a fitting as the function of a vent is to release excess gas.

- Air Valve
- Dam Chase
- Fitting
- Meter
- Vent Column

Operational Controls

A feature in a sewer that changes or diverts the flow in the sewer. Example: A hydrobrake limits the flow passing downstream.

- Control Valve
- Drop Pipe
- Ancillary
- Weir

Other Symbols

Symbols used on maps which do not fall under other general categories

- Public/Private Pumping Station
- Change of characteristic indicator (C.O.C.I.)
- Invert Level
- Summit

Areas

Lines denoting areas of underground surveys, etc.

- Agreement
- Operational Site
- Chamber
- Tunnel
- Conduit Bridge

Other Sewer Types (Not Operated or Maintained by Thames Water)

- Foul Sewer
- Surface Water Sewer
- Combined Sewer
- Gully
- Culverted Watercourse
- Proposed
- Abandoned Sewer


End Items

End symbols appear at the start or end of a sewer pipe. Examples: an Undefined End at the start of a sewer indicates that Thames Water has no knowledge of the position of the sewer upstream of that symbol. Outfall on a surface water sewer indicates that the pipe discharges into a stream or river.

- Outfall
- Undefined End
- Inlet

Notes:

- All levels associated with the plans are to Ordnance Datum Newlyn.
- All measurements on the plans are metric.
- Arrows (on gravity fed sewers) or flecks (on rising mains) indicate direction of flow.
- Most private pipes are not shown on our plans, as in the past, this information has not been recorded.
- 'na' or '0' on a manhole level indicates that data is unavailable.
- The text appearing alongside a sewer line indicates the internal diameter of the pipe in millimetres. Text next to a manhole indicates the manhole reference number and should not be taken as a measurement. If you are unsure about any text or symbology present on the plan, please contact a member of Property Insight on 0845 070 9148.

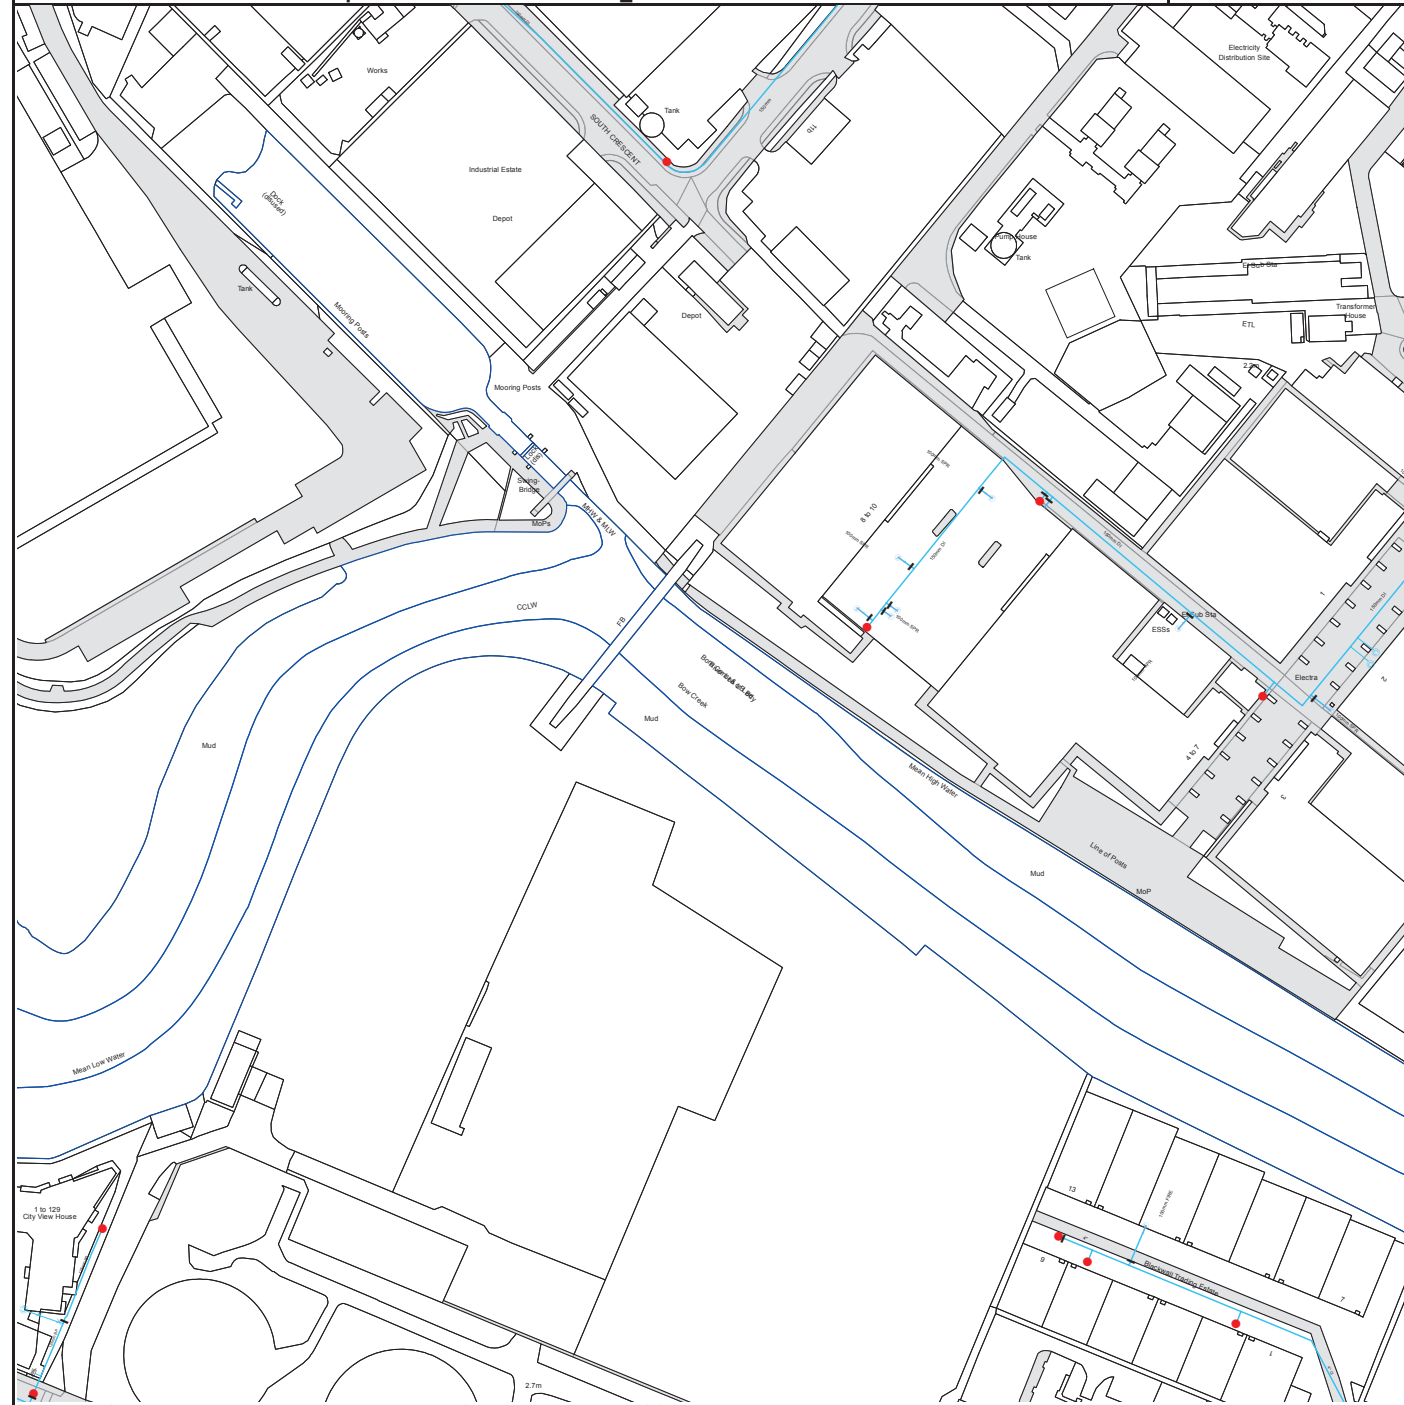

The width of the displayed area is 500m and the centre of the map is located at OS coordinates 538750,181750

The position of the apparatus shown on this plan is given without obligation and warranty, and the accuracy cannot be guaranteed. Service pipes are not shown but their presence should be anticipated. No liability of any kind whatsoever is accepted by Thames Water for any error or omission. The actual position of mains and services must be verified and established on site before any works are undertaken.


Based on the Ordnance Survey Map with the Sanction of the controller of H.M. Stationery Office, License no. 100019345 Crown Copyright Reserved.




The width of the displayed area is 500m and the centre of the map is located at OS coordinates 538250,181250

The position of the apparatus shown on this plan is given without obligation and warranty, and the accuracy cannot be guaranteed. Service pipes are not shown but their presence should be anticipated. No liability of any kind whatsoever is accepted by Thames Water for any error or omission. The actual position of mains and services must be verified and established on site before any works are undertaken.

Based on the Ordnance Survey Map with the Sanction of the controller of H.M. Stationery Office, License no. 100019345 Crown Copyright Reserved.

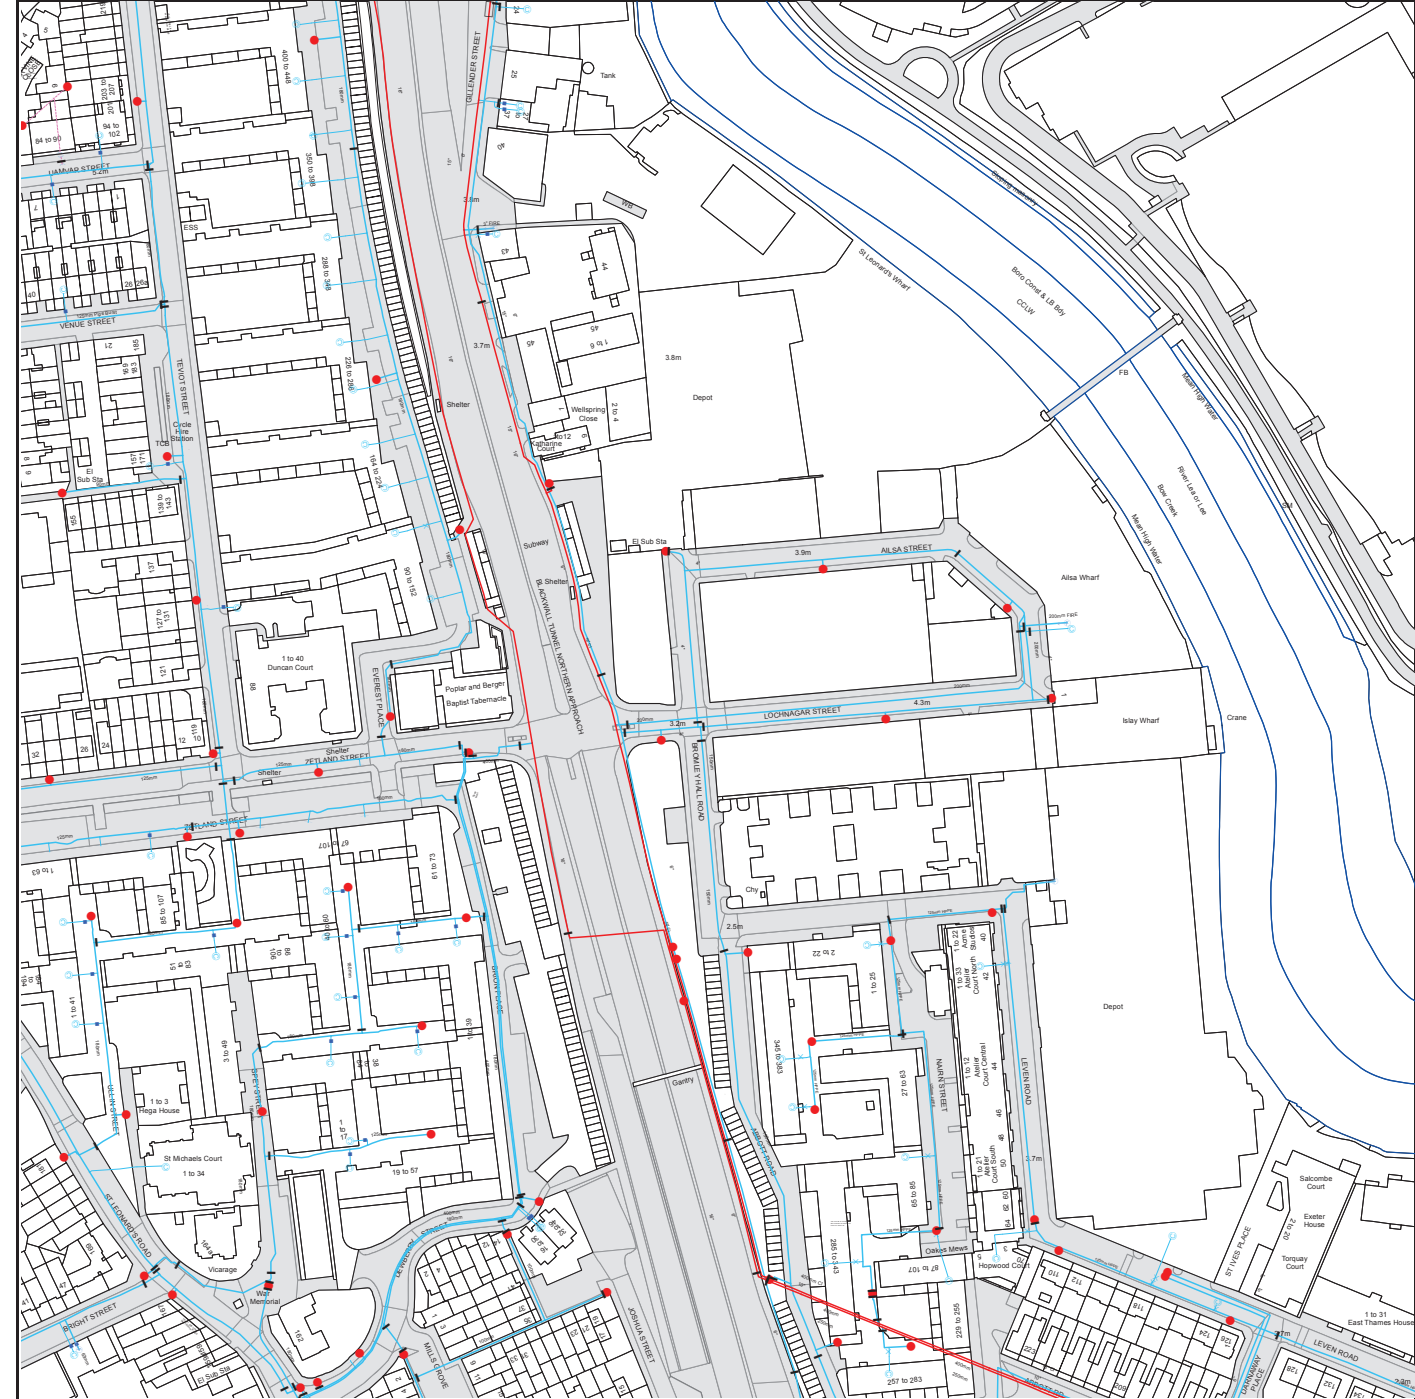

The width of the displayed area is 500m and the centre of the map is located at OS coordinates 538250,181750
 The position of the apparatus shown on this plan is given without obligation and warranty, and the accuracy cannot be guaranteed. Service pipes are not shown but their presence should be anticipated. No liability of any kind whatsoever is accepted by Thames Water for any error or omission. The actual position of mains and services must be verified and established on site before any works are undertaken.
 Based on the Ordnance Survey Map with the Sanction of the controller of H.M. Stationery Office, License no. 100019345 Crown Copyright Reserved.

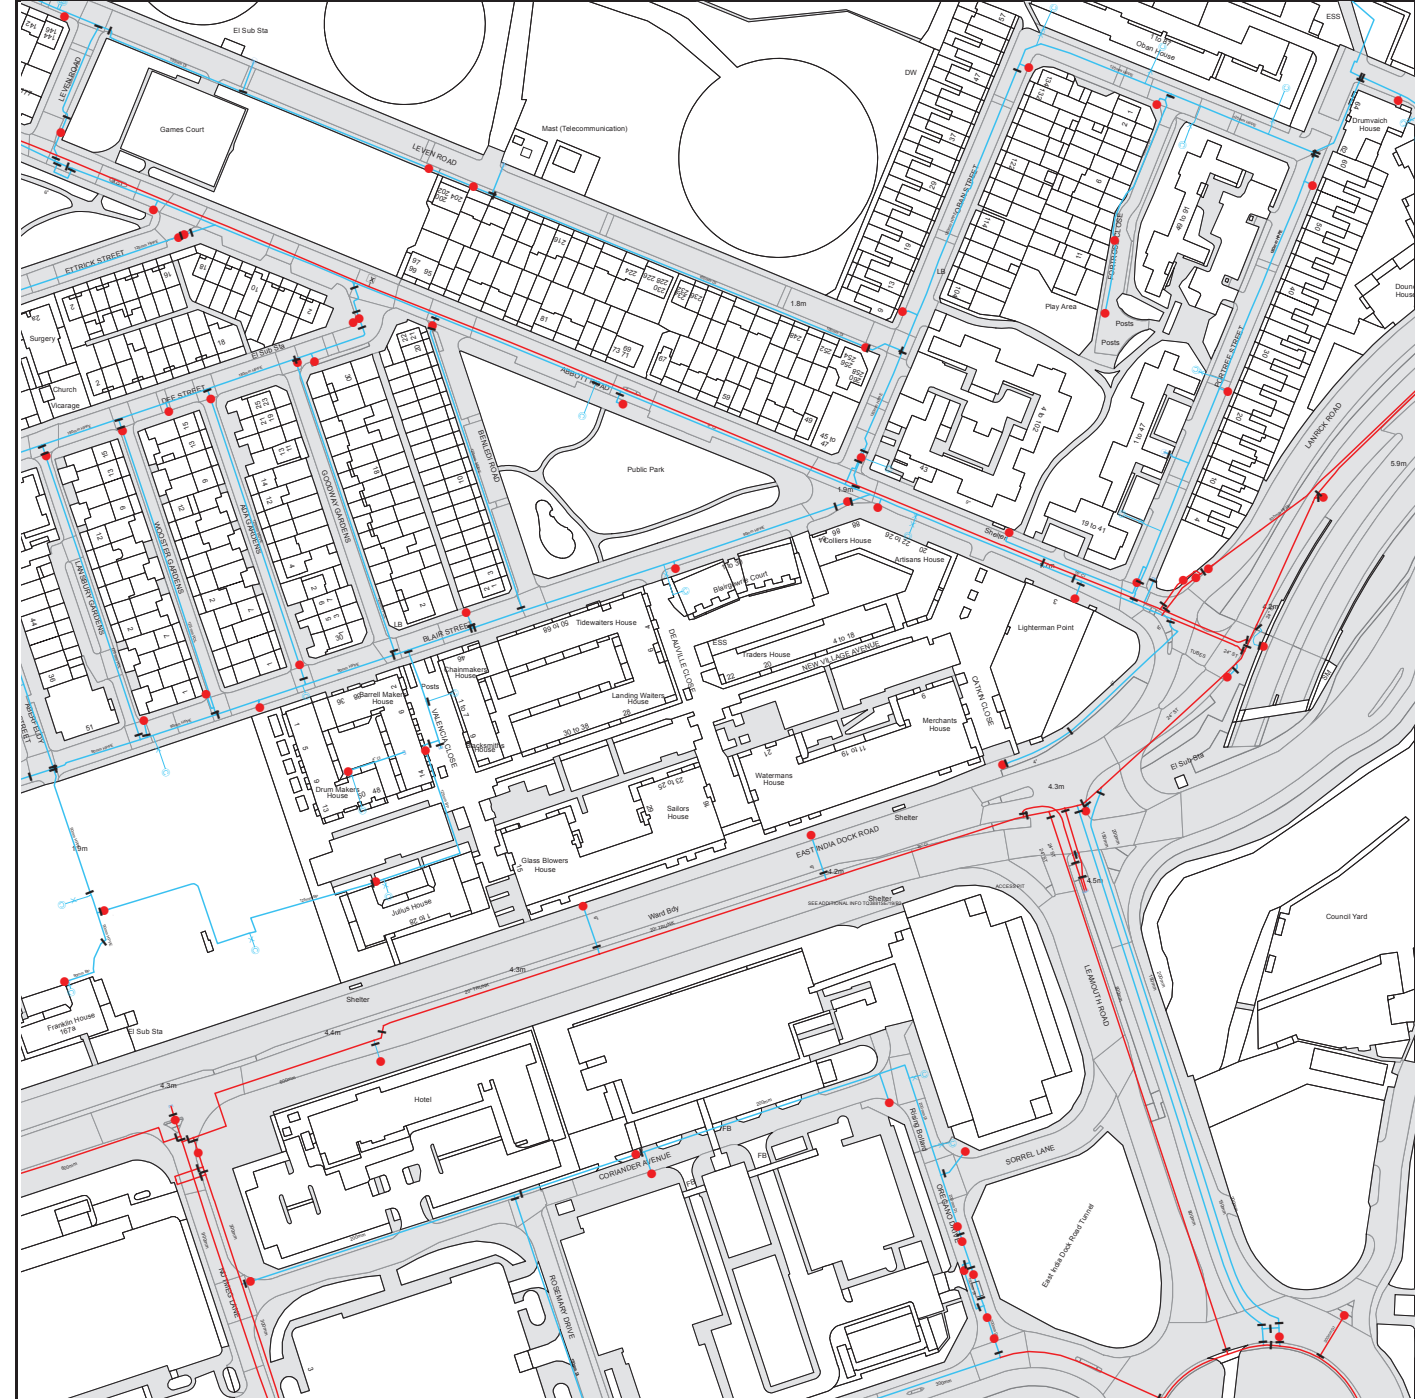

The width of the displayed area is 500m and the centre of the map is located at OS coordinates 538750,181250
 The position of the apparatus shown on this plan is given without obligation and warranty, and the accuracy cannot be guaranteed. Service pipes are not shown but their presence should be anticipated. No liability of any kind whatsoever is accepted by Thames Water for any error or omission. The actual position of mains and services must be verified and established on site before any works are undertaken.
 Based on the Ordnance Survey Map with the Sanction of the controller of H.M. Stationery Office, License no. 100019345 Crown Copyright Reserved.



ALS Water Map Key

Water Pipes (Operated & Maintained by Thames Water)

- 4"** **Distribution Main:** The most common pipe shown on water maps. With few exceptions, domestic connections are only made to distribution mains.
- 16"** **Trunk Main:** A main carrying water from a source of supply to a treatment plant or reservoir, or from one treatment plant or reservoir to another. Also a main transferring water in bulk to smaller water mains used for supplying individual customers.
- 3" SUPPLY** **Supply Main:** A supply main indicates that the water main is used as a supply for a single property or group of properties.
- 3" FIRE** **Fire Main:** Where a pipe is used as a fire supply, the word FIRE will be displayed along the pipe.
- 3" METERED** **Metered Pipe:** A metered main indicates that the pipe in question supplies water for a single property or group of properties and that quantity of water passing through the pipe is metered even though there may be no meter symbol shown.
- Transmission Tunnel:** A very large diameter water pipe. Most tunnels are buried very deep underground. These pipes are not expected to affect the structural integrity of buildings shown on the map provided.
- Proposed Main:** A main that is still in the planning stages or in the process of being laid. More details of the proposed main and its reference number are generally included near the main.

PIPE DIAMETER	DEPTH BELOW GROUND
Up to 300mm (12")	900mm (3')
300mm - 600mm (12" - 24")	1100mm (3' 8")
600mm and bigger (24" plus)	1200mm (4')

Valves

- General Purpose Valve
- Air Valve
- Pressure Control Valve
- Customer Valve

Hydrants

- Single Hydrant

Meters

- Meter

End Items

Symbol indicating what happens at the end of a water main.

- Blank Flange
- Capped End
- Emptying Pit
- Undefined End
- Manifold
- Customer Supply
- Fire Supply

Operational Sites

- Booster Station
- Other
- Other (Proposed)
- Pumping Station
- Service Reservoir
- Shaft Inspection
- Treatment Works
- Unknown
- Water Tower

Other Symbols

- Data Logger

Other Water Pipes (Not Operated or Maintained by Thames Water)

- Other Water Company Main:** Occasionally other water company water pipes may overlap the border of our clean water coverage area. These mains are denoted in purple and in most cases have the owner of the pipe displayed along them.
- Private Main:** Indicates that the water main in question is not owned by Thames Water. These mains normally have text associated with them indicating the diameter and owner of the pipe.

Terms and Conditions

All sales are made in accordance with Thames Water Utilities Limited (TWUL) standard terms and conditions unless previously agreed in writing.

1. All goods remain in the property of Thames Water Utilities Ltd until full payment is received.
2. Provision of service will be in accordance with all legal requirements and published TWUL policies.
3. All invoices are strictly due for payment 14 days from due date of the invoice. Any other terms must be accepted/agreed in writing prior to provision of goods or service, or will be held to be invalid.
4. Thames Water does not accept post-dated cheques-any cheques received will be processed for payment on date of receipt.
5. In case of dispute TWUL's terms and conditions shall apply.
6. Penalty interest may be invoked by TWUL in the event of unjustifiable payment delay. Interest charges will be in line with UK Statute Law 'The Late Payment of Commercial Debts (Interest) Act 1998'.
7. Interest will be charged in line with current Court Interest Charges, if legal action is taken.
8. A charge may be made at the discretion of the company for increased administration costs.

A copy of Thames Water's standard terms and conditions are available from the Commercial Billing Team (cashoperations@thameswater.co.uk).

We publish several Codes of Practice including a guaranteed standards scheme. You can obtain copies of these leaflets by calling us on 0800 316 9800

If you are unhappy with our service you can speak to your original goods or customer service provider. If you are not satisfied with the response, your complaint will be reviewed by the Customer Services Director. You can write to her at: Thames Water Utilities Ltd. PO Box 492, Swindon, SN38 8TU.

If the Goods or Services covered by this invoice falls under the regulation of the 1991 Water Industry Act, and you remain dissatisfied you can refer your complaint to Consumer Council for Water on 0121 345 1000 or write to them at Consumer Council for Water, 1st Floor, Victoria Square House, Victoria Square, Birmingham, B2 4AJ.

Ways to pay your bill

Credit Card	BACS Payment	Telephone Banking	Cheque
Call 0845 070 9148 quoting your invoice number starting CBA or ADS / OSS	Account number 90478703 Sort code 60-00-01 A remittance advice must be sent to: Thames Water Utilities Ltd., PO Box 3189, Slough SL1 4WW. or email ps.billing@thameswater.co.uk	By calling your bank and quoting: Account number 90478703 Sort code 60-00-01 and your invoice number	Made payable to ' Thames Water Utilities Ltd ' Write your Thames Water account number on the back. Send to: Thames Water Utilities Ltd., PO Box 3189, Slough SL1 4WW or by DX to 151280 Slough 13

Thames Water Utilities Ltd Registered in England & Wales No. 2366661 Registered Office Clearwater Court, Vastern Rd, Reading, Berks, RG1 8DB.

Appendix B

Site Photographs



Photo 01: Petrol warning signs on areas present between Abbot Road and Nairn Street (north of site)

Photo 02: Electricity substation in development next to Braithwaite Park



Photo 03: Fly tipping off Lochnager Road

Photo 04: Blairgowrie Court



Photo 05: Blairgowrie Park underground waste storage system



Photo 06: Aberfeldy Street



Photo 07: Area of hardstanding on Lansbury Gardens

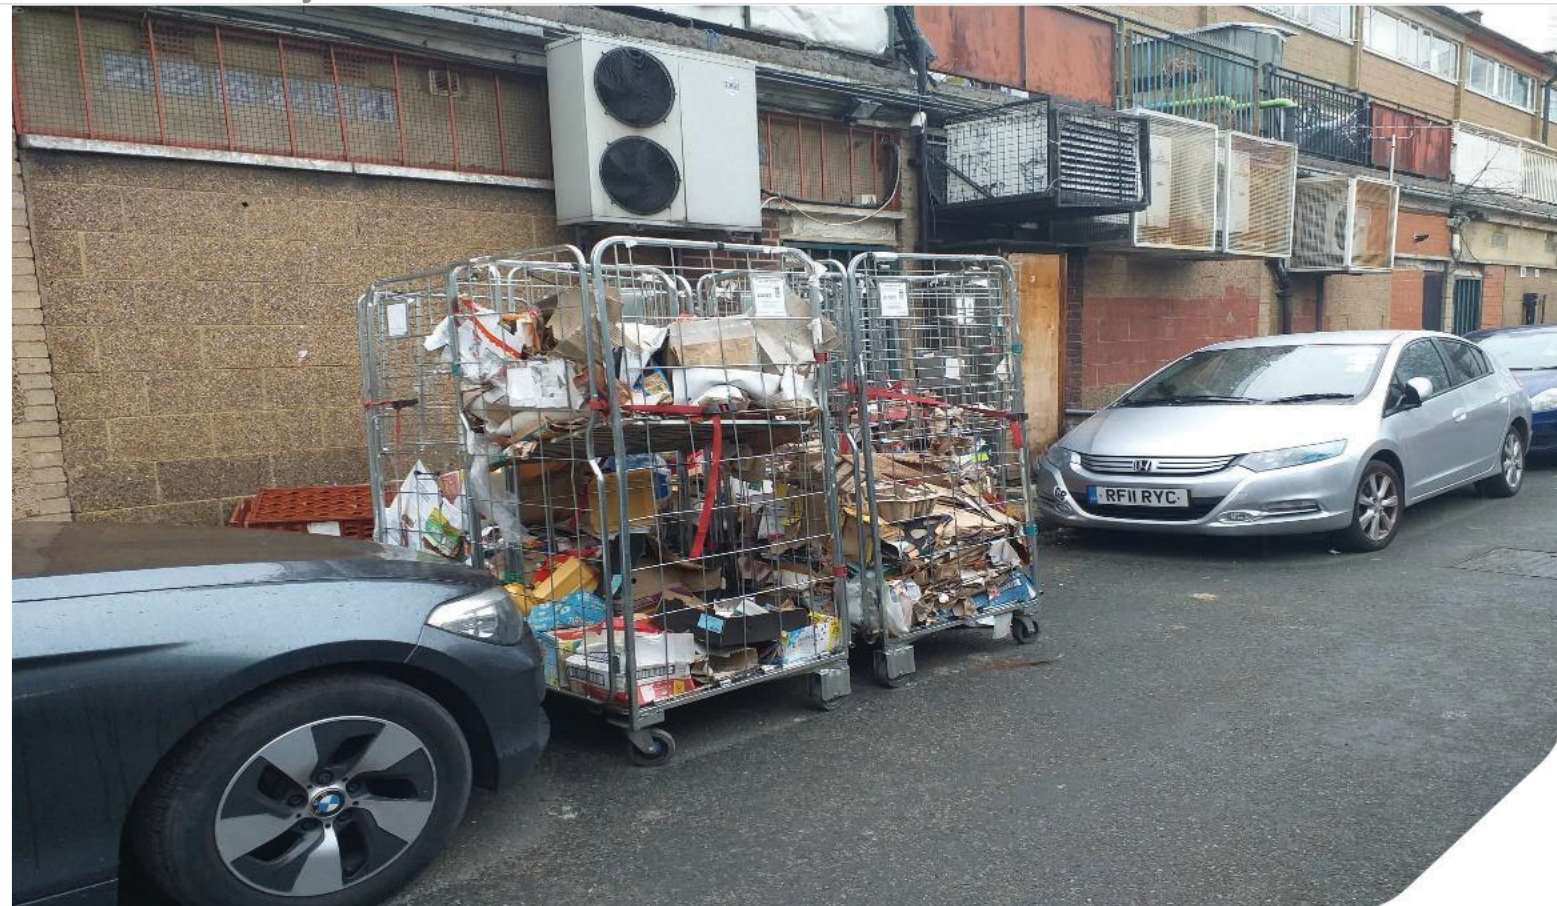


Photo 08: Aircon units and waste on Kirkmichael Road



Photo 09: Wheeled waste bins at junction of Aberfeldy Road and Dee Street



Photo 10: Aberfeldy Neighbourhood Centre



Photo 11: Park associated with Aberfeldy Neighbourhood Centre



Plate 12: Gardens in the development between Dee Street and Etrick Street



Photo 13: Wheeled general waste bins on Cullen Street



Photo 14: Flats off Findhorn Street



Photo 15: Residential Properties along Balmore Close



Photo 16: Play parks at the end of Balmore Close