



PADDINGTON GREEN
POLICE STATION

January 2023

Fire Statement Appendix A


Fire Statement Appendix A– January 2023 –

GLA0711 AMND Rev 01 January 2023



Do not scale from this drawing. All dimensions to be checked on site. All omissions and discrepancies to be reported to the Architect immediately

This work is copyright and shall not be reproduced or used for any other purpose without the written permission of Squire and Partners.

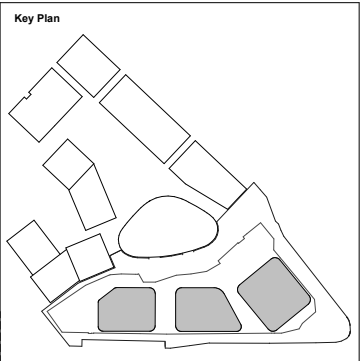

For Information	07/10/22	EJ	P05
Issued to GLA	20/09/22	EJ	P04
Issued to GLA	07/09/22	EJ	P03
Issued as Draft	28/07/22	EJ	P02
Issued as Draft	16/06/22	EJ	P01
Description	Date	Chk	Rev

SQUIRE & PARTNERS

Squire and Partners LLP
The Department Store
248 Ferndale Road, London SW9 8FR
T: 020 7278 5555
info@squireandpartners.com
www.squireandpartners.com

Project
Paddington Green Police Station
London, W2

Title
Proposed Basement Plan -2


Suitability Status
S2 For Information

Date Scale @ ISO A1 Job Number
26/03/21 1:250 15044

Drawing Number Revision
15044-SQP-ZZ-B2-DP-A-PL01102 P05

Annotation	Description
	Car Park
	Vented Lobbies
	Ancillary Areas


Annotation	Description
	30 Minutes FR
	60 Minutes FR
	120 Minutes FR
	240 Minutes FR
	FD 30 S Fire Door
	FD 30 Fire Door
	FD 60 S Fire Door
	FD 60 Fire Door
	FD 120 S Fire Door
	FD 120 Fire Door

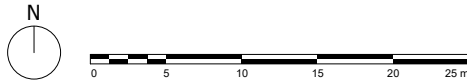



Do not scale from this drawing. All dimensions to be checked on site. All omissions and discrepancies to be reported to the Architect immediately

This work is copyright and shall not be reproduced or used for any other purpose without the written permission of Squire and Partners.

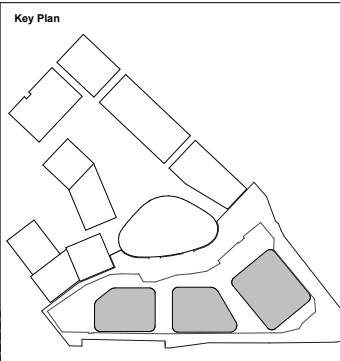

- Key
- Proposed Planning Boundary
 - Site Ownership Boundary
 - Cycle Shortfall Reallocation

Basement 1 Residential Cycle Provisions

Block I =
386 Josta + 34 Shef. Standard + 17 Shef. Oversized = 437

Block J =
212 Josta + 27 Shef. Standard + 18 Shef. Oversized = 257

Block K =
130 Josta + 46 Shef. Standard + 16 Shef. Oversized = 192

TOTAL = 886 Cycle Spaces
+ 118 shortfall Cycle Spaces in WEG
TOTAL = 1004 CYCLE SPACES

Issued for Planning 18/11/22 P2
Issued for Planning 26/03/21 P1
Description Date Chk Rev

SQUIRE & PARTNERS

Squire and Partners LLP
The Department Store
248 Ferndale Road, London SW9 8FR
T: 020 7278 5555

info@squireandpartners.com
www.squireandpartners.com


Project
Paddington Green Police Station
London, W2

Title
Proposed Basement Plan -1

Suitability Status
S2 For Information

Date Scale @ ISO A1 Job Number
26/03/21 1:250 15044


Drawing Number Revision
15044-SQP-ZZ-B1-DP-A-PL01103 P2

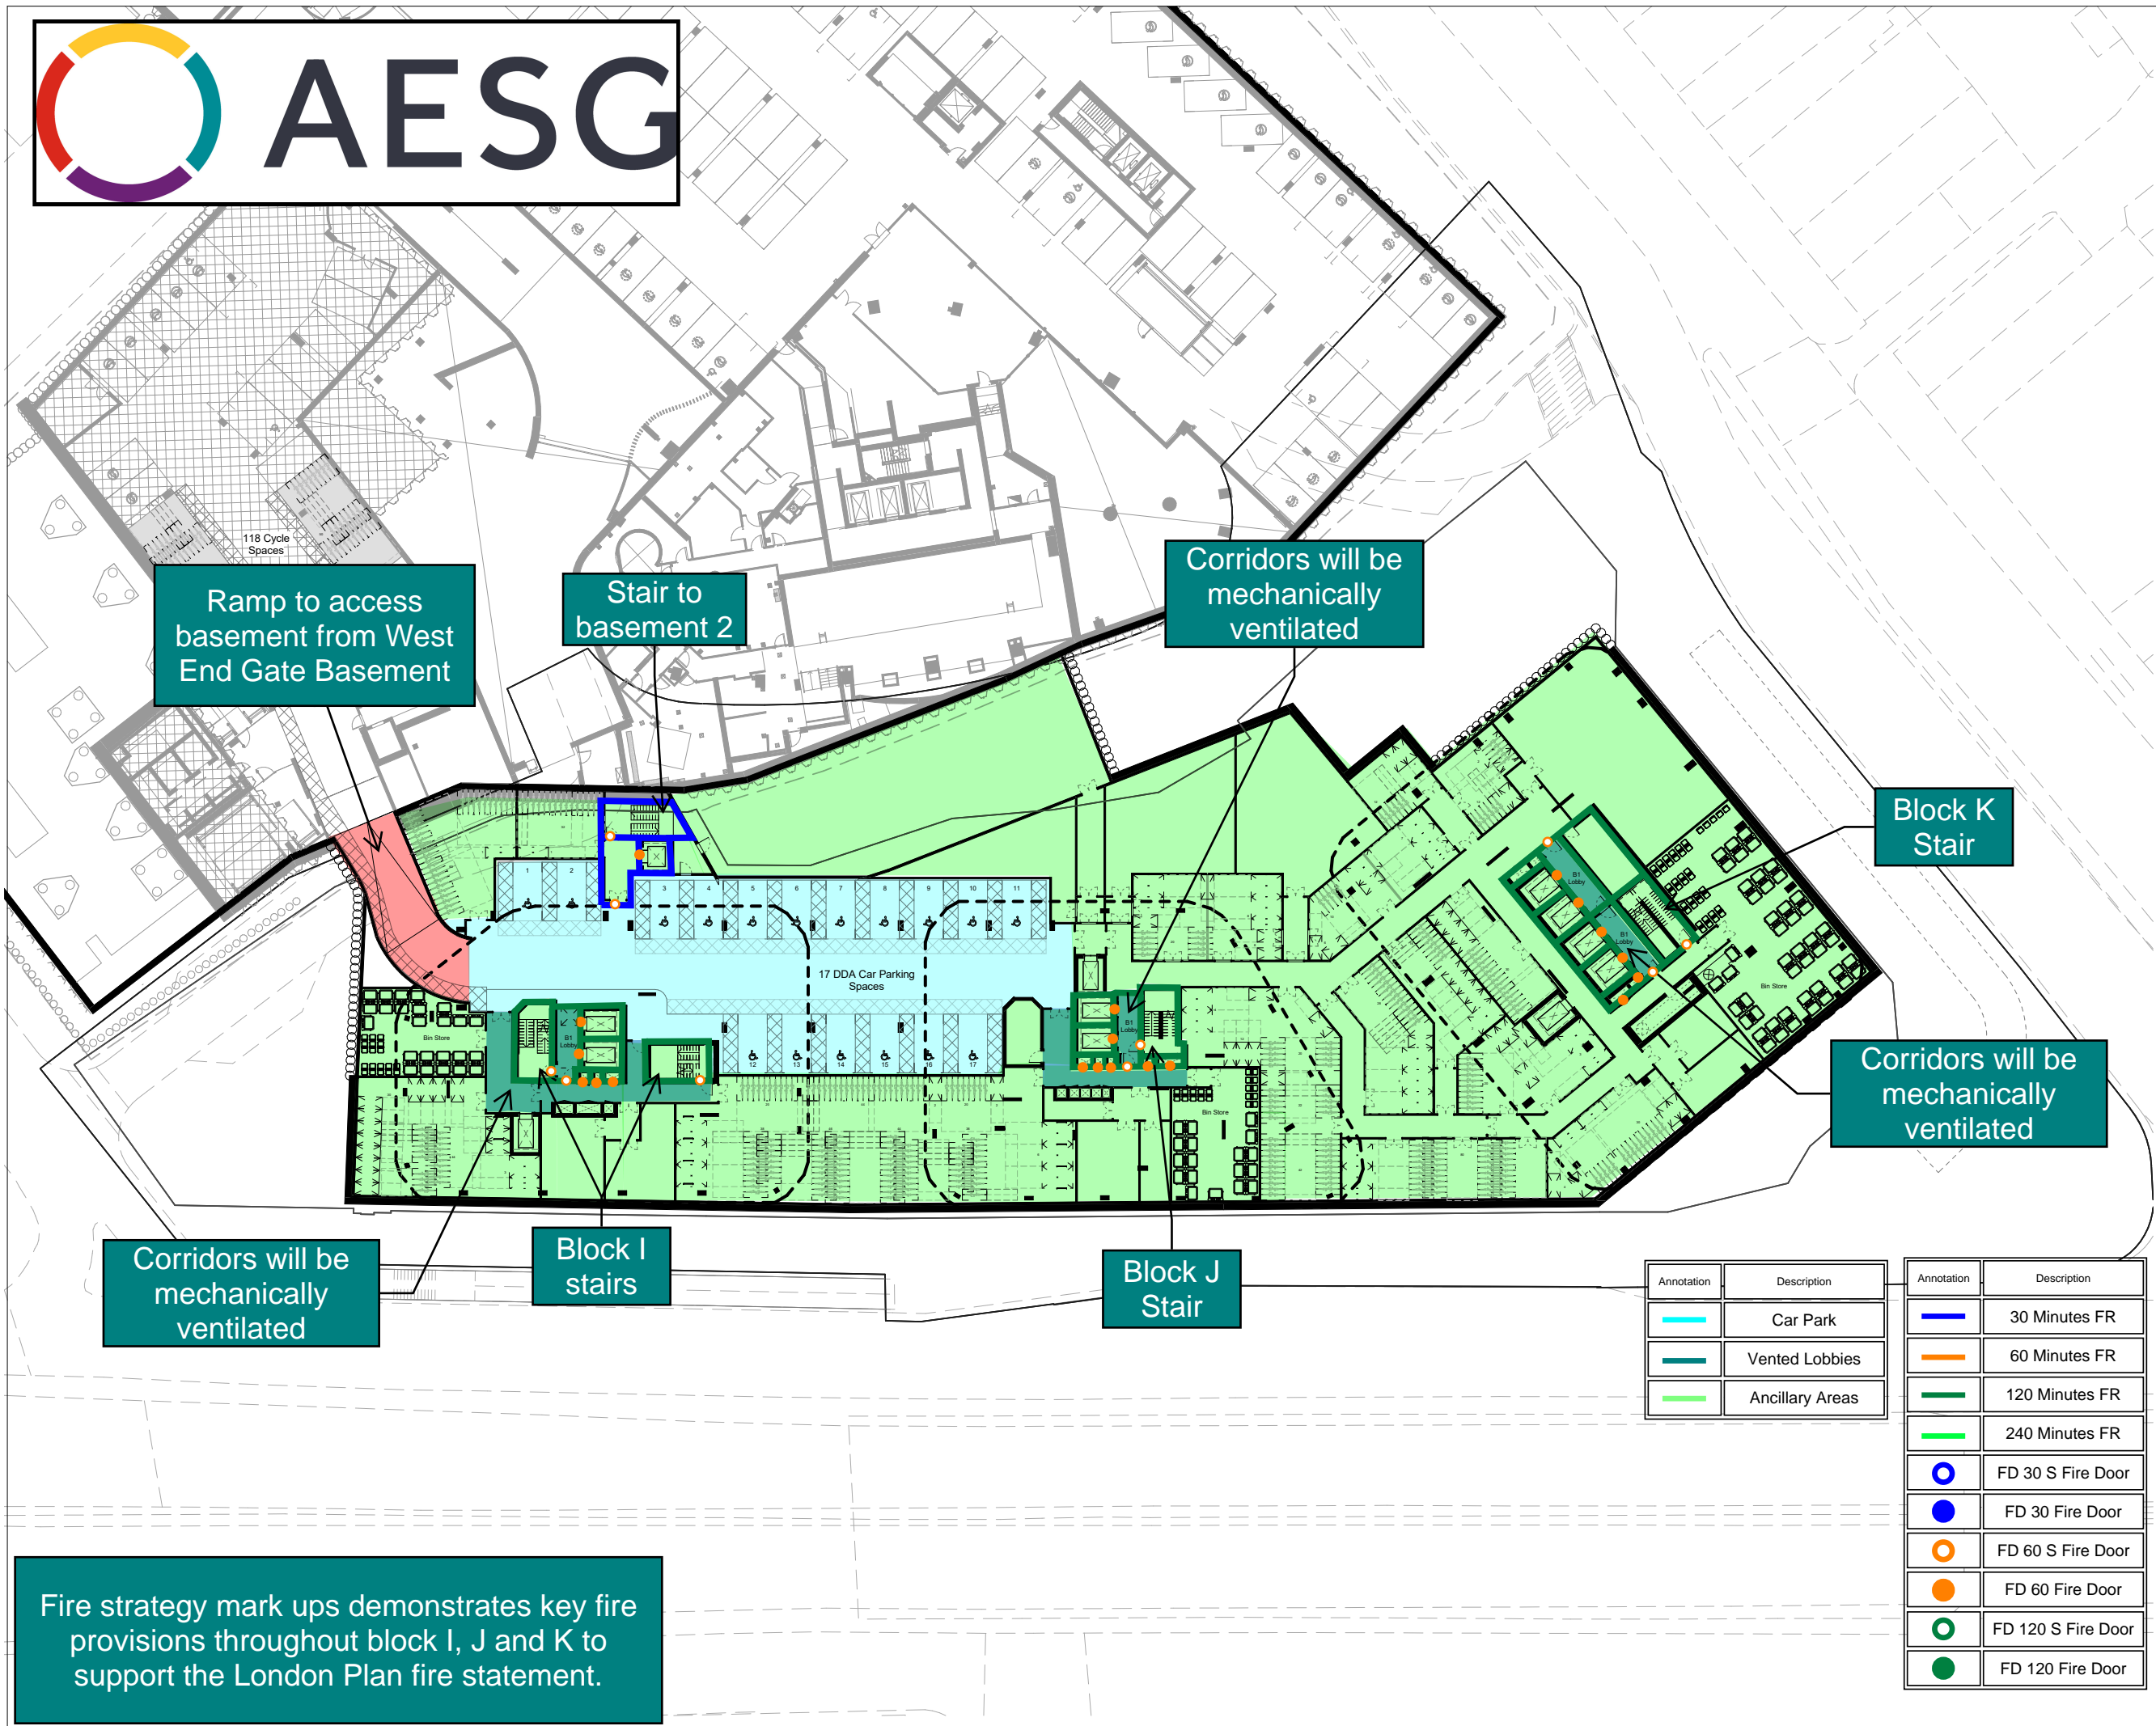

Annotation	Description
	Car Park
	Vented Lobbies
	Ancillary Areas

Annotation	Description
	30 Minutes FR
	60 Minutes FR
	120 Minutes FR
	240 Minutes FR
	FD 30 S Fire Door
	FD 30 Fire Door
	FD 60 S Fire Door
	FD 60 Fire Door
	FD 120 S Fire Door
	FD 120 Fire Door


Fire strategy mark ups demonstrates key fire provisions throughout block I, J and K to support the London Plan fire statement.

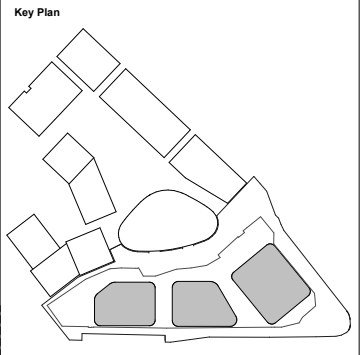

Key

— Proposed Planning Boundary

— Site Ownership Boundary

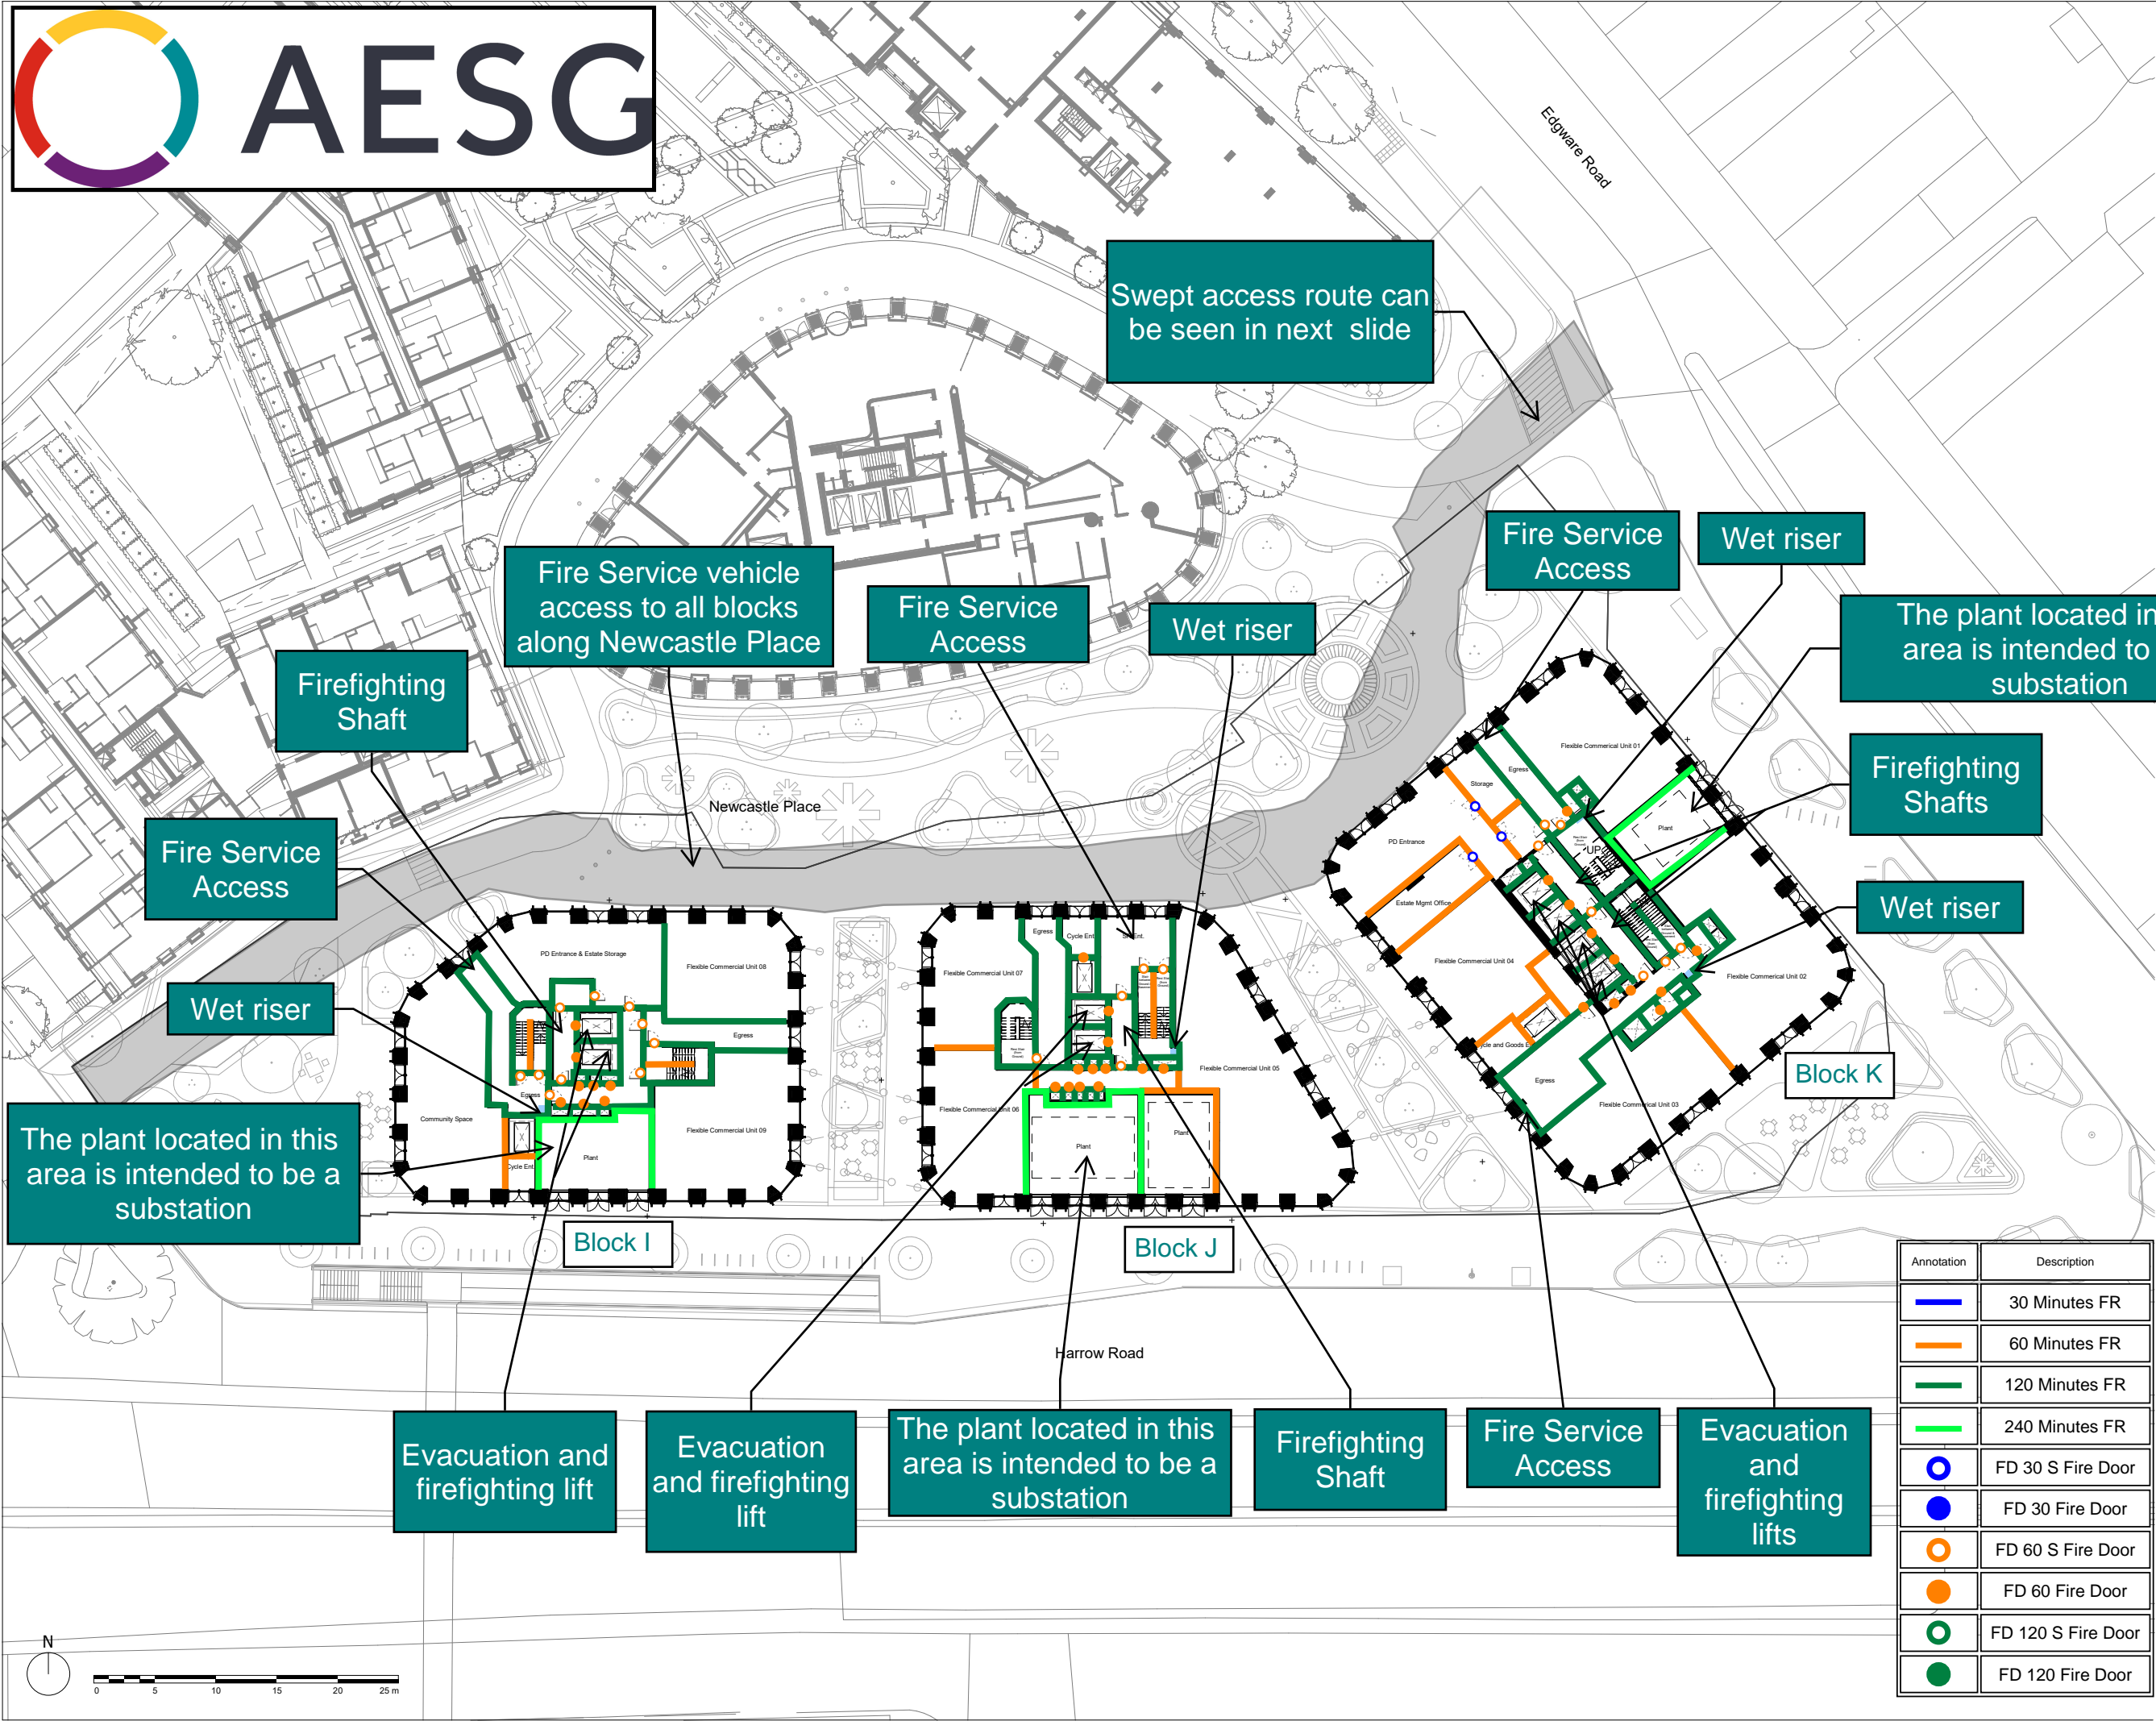

Issued for Planning	18/11/22	P3
Planning Amendments	23/07/21	P2
Issued for Planning	26/03/21	P1
Description	Date	Chk

SQUIRE & PARTNERS

Squire and Partners LLP
The Department Store
248 Ferndale Road, London SW9 8FR
T: 020 7278 5555
info@squireandpartners.com
www.squireandpartners.com

Project
Paddington Green Police Station
London, W2


Title
Proposed Ground Floor Plan


Suitability Status
S2 For Information

Date Scale @ ISO A1 Job Number
08/12/21 1:250 15044

Drawing Number Revision
15044-SQP-ZZ-00-DP-A-PL01104 P3

Annotation	Description
	30 Minutes FR
	60 Minutes FR
	120 Minutes FR
	240 Minutes FR
	FD 30 S Fire Door
	FD 30 Fire Door
	FD 60 S Fire Door
	FD 60 Fire Door
	FD 120 S Fire Door
	FD 120 Fire Door

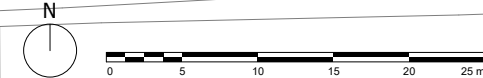


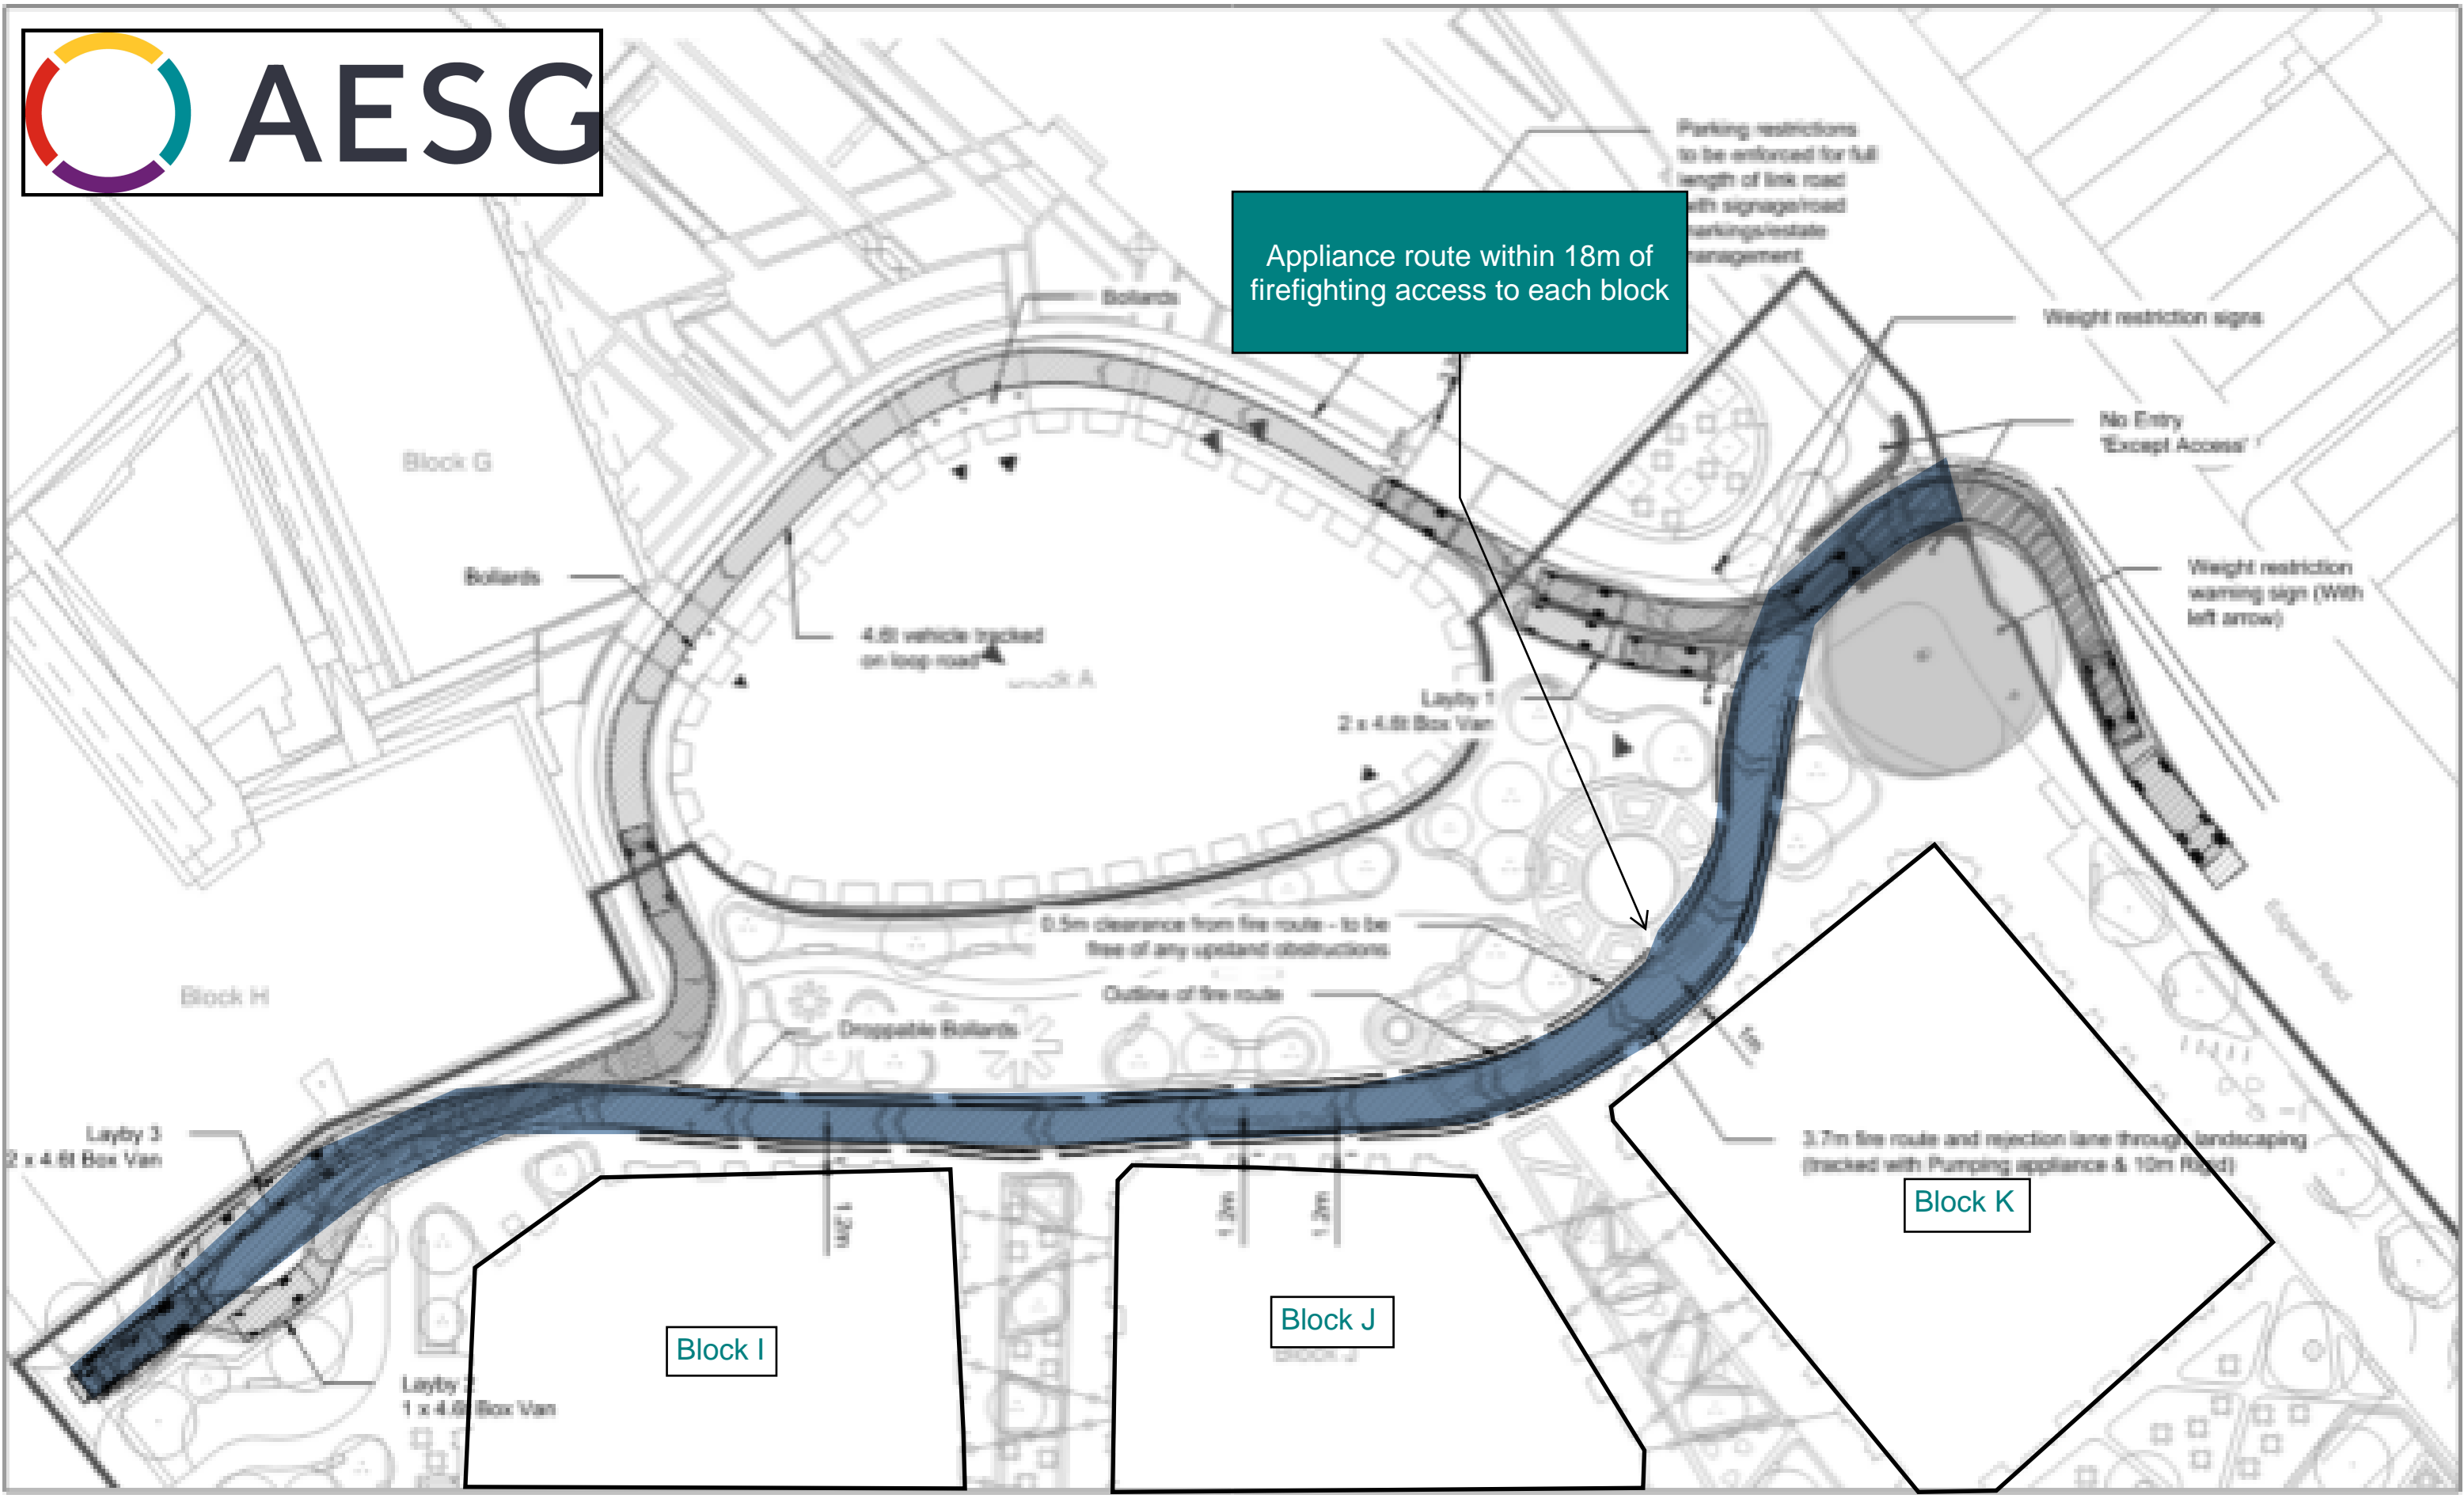



Do not scale from this drawing. All dimensions to be checked on site. All omissions and discrepancies to be reported to the Architect immediately

This work is copyright and shall not be reproduced or used for any other purpose without the written permission of Squire and Partners.

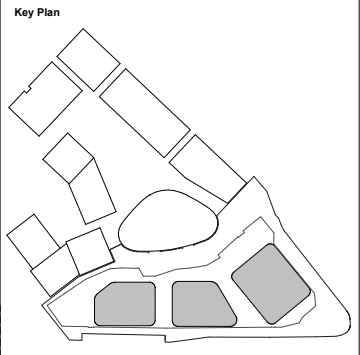

- Key
- Proposed Planning Boundary
 - Site Ownership Boundary

Assembly Point (2)

Assembly Point (3)

Assembly Point (1)

Issued for Planning	18/11/22	P3
Planning Amendments	23/07/21	P2
Issued for Planning	26/03/21	P1
Description	Date	Chk Rev

SQUIRE & PARTNERS

Squire and Partners LLP
The Department Store
248 Ferndale Road, London SW9 8FR
T: 020 7278 5555

info@squireandpartners.com
www.squireandpartners.com

Project
Paddington Green Police Station
London, W2

Title
Proposed Ground Floor Plan

Suitability	Status	
S2	For Information	
Date	Scale @ ISO A1	Job Number
08/12/21	1:250	15044
Drawing Number		Revision
15044-SQP-ZZ-00-DP-A-PL01104		P3

